


T.9S. R.43E.W.M.

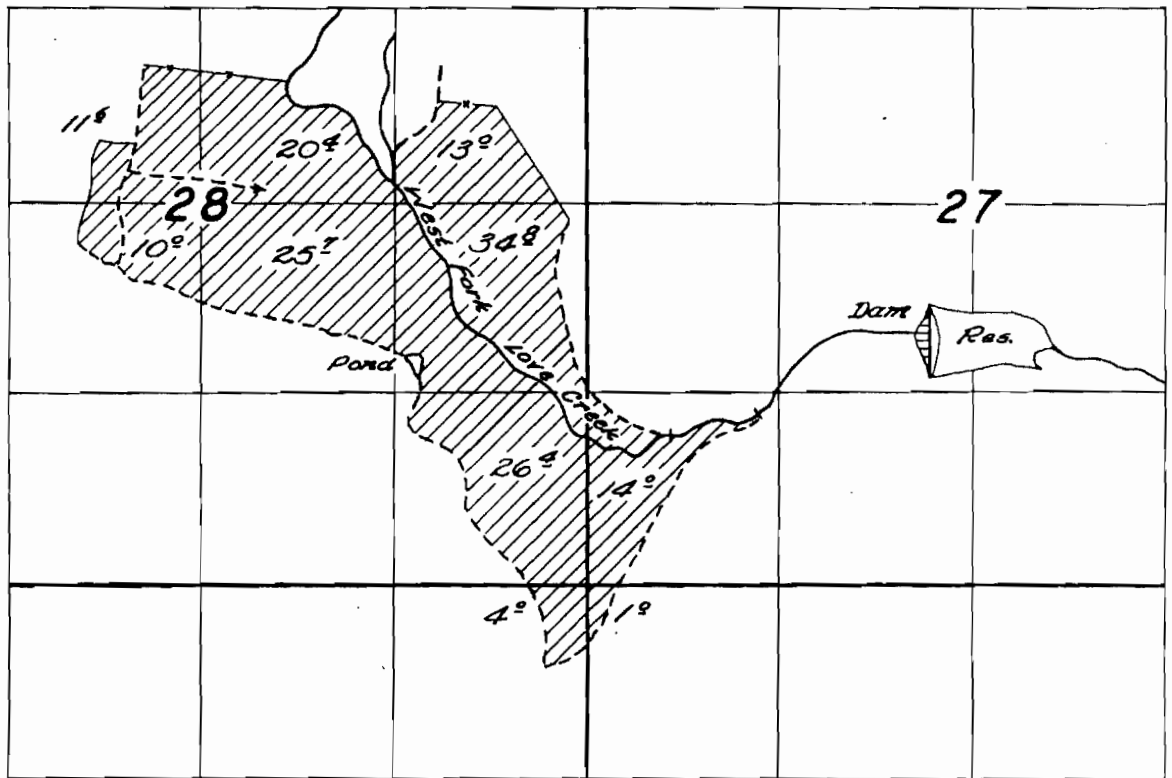

FINAL PROOF SURVEY
UNDER

Application No. *R-26287* Permit No. *R-1238*
26288 *20633*
IN NAME OF

John Widman

Surveyed *Sept. 25* 1958, by *C.O. Bartek*