

# FINAL PROOF MAP

IN THE NAME OF


VELMER M. DAUGHERTY

APPLICATION NO. 72529

PERMIT NO. 51533


NOV. 21, 1994

DEC 14 1994

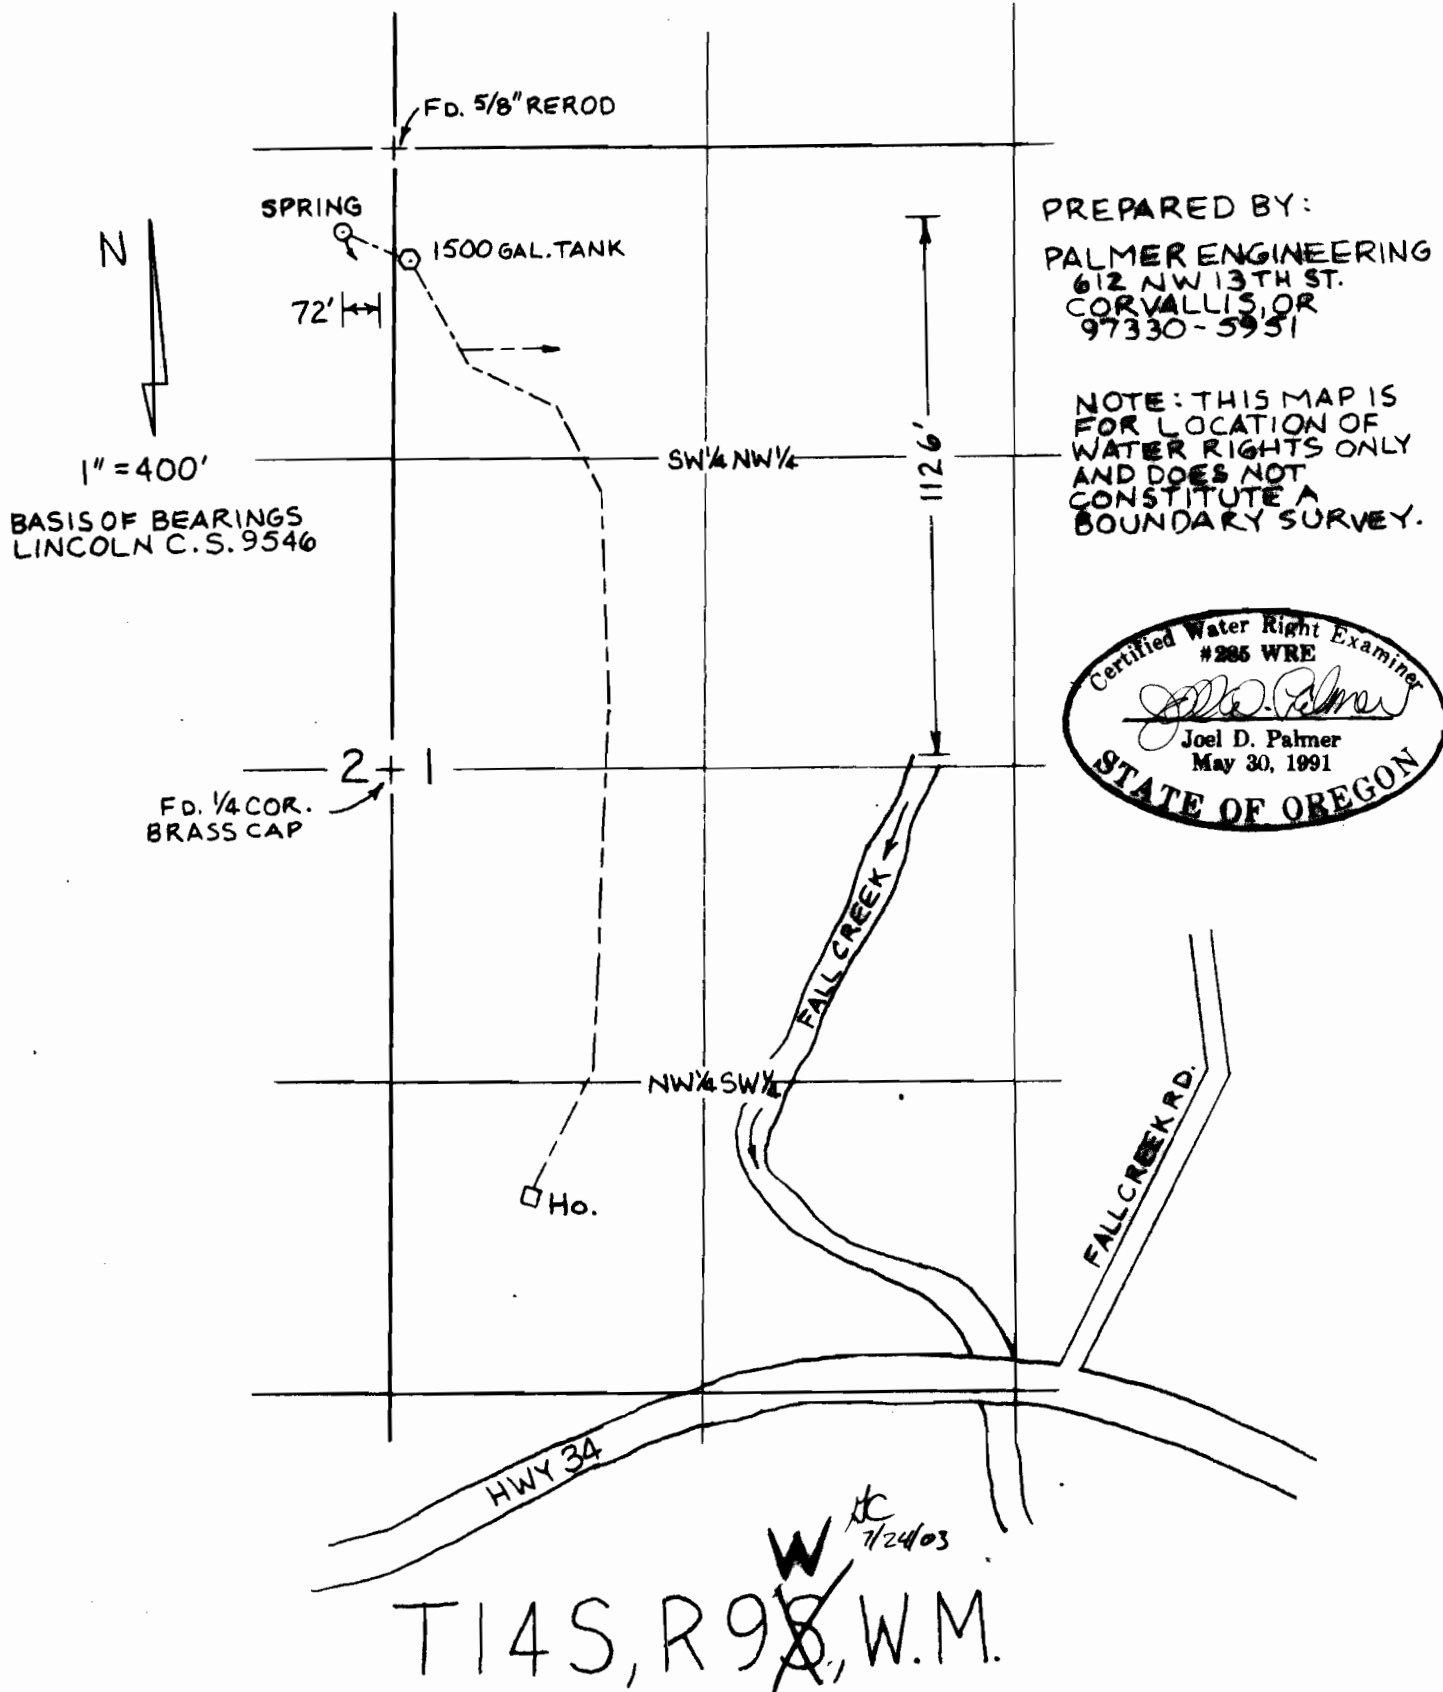

PREPARED BY:  
PALMER ENGINEERING  
612 NW 13TH ST.  
CORVALLIS, OR  
97330-5951

NOTE: THIS MAP IS  
FOR LOCATION OF  
WATER RIGHTS ONLY  
AND DOES NOT  
CONSTITUTE A  
BOUNDARY SURVEY.

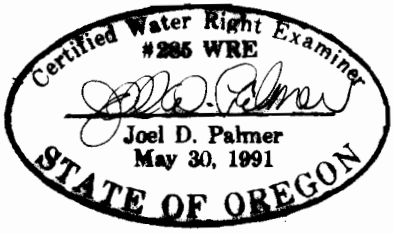

W 72403  
T14S, R9~~8~~, W.M.