


T.I.N., R.I.E., W.M.

RECEIVED

MAR 31 1993

WATER RESOURCES DEPT
SALEM, OREGON

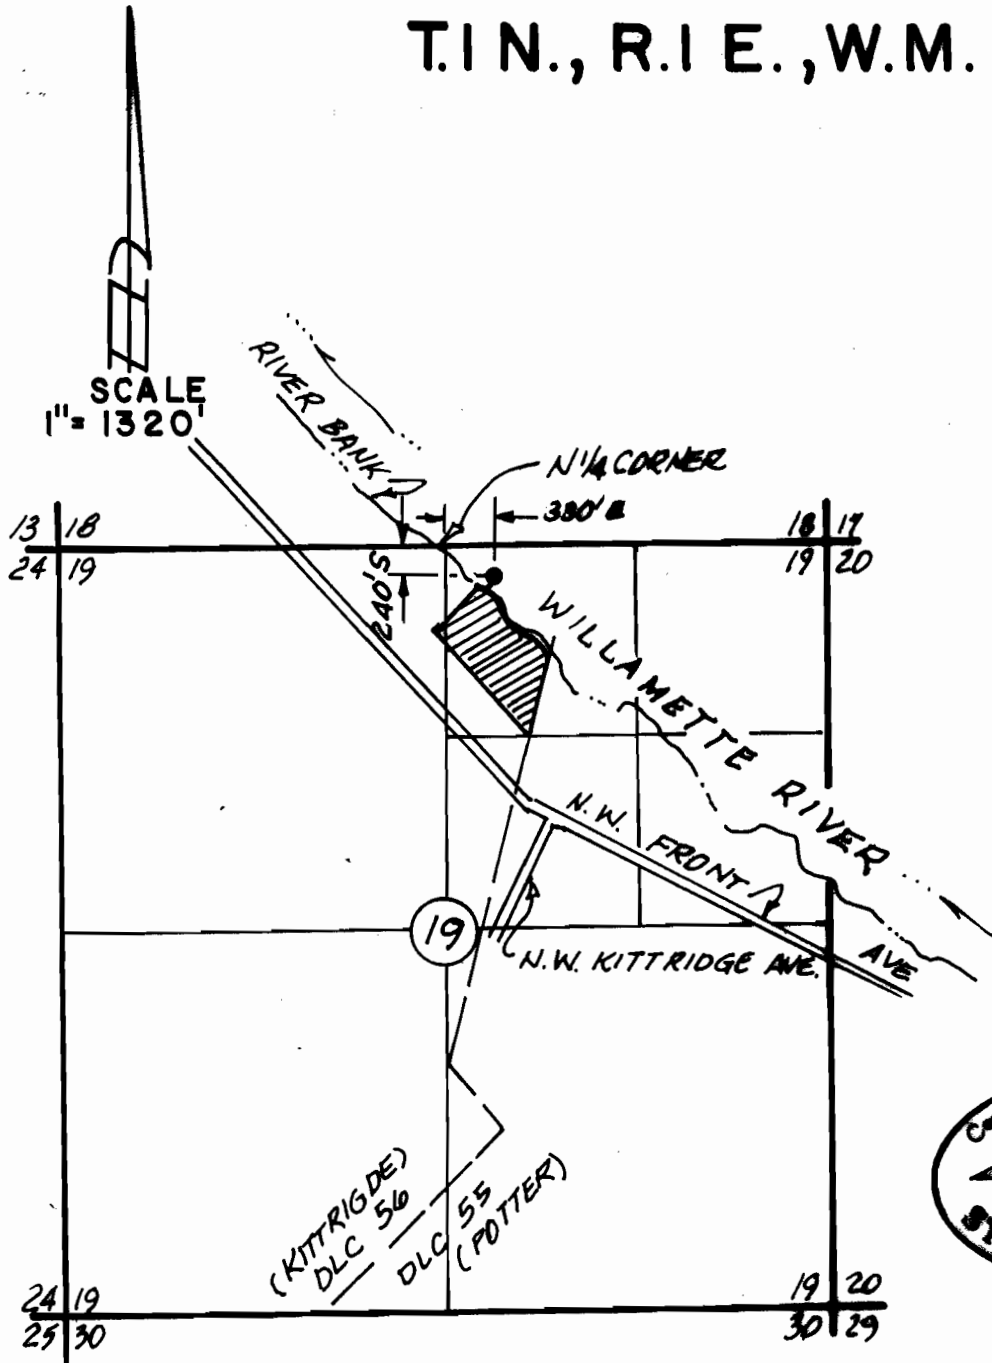

FINAL PROOF SURVEY

UNDER

APPLICATION NO. 70968 PERMIT NO. 51444

IN NAME OF LONE STAR NORTHWEST

THIS MAP WAS PREPARED FOR THE PURPOSE OF IDENTIFYING THE LOCATION OF WATER RIGHTS ONLY AND HAS NO INTENT TO PROVIDE DEMENSIONS OR LOCATION OF PROPERTY OWNERSHIP LINES.

COMSTOCK NORTHWEST, INC
2450 S.E. BELMONT ST.
PORTLAND OR 97214
(503) 234-8112