
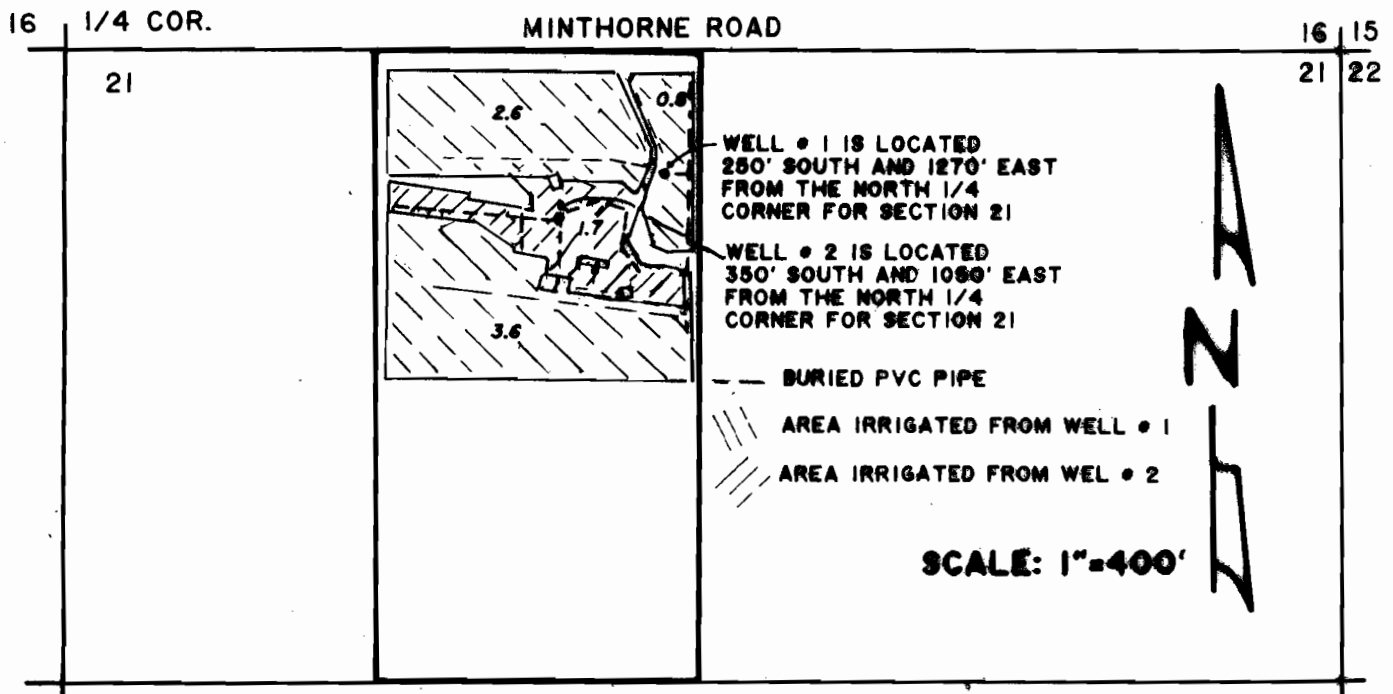


T. 35 S., R. 4 W., W.M.

SECTION 21 NW 1/4, NE 1/4

THIS MAP IS FOR THE PURPOSE OF IDENTIFYING THE LOCATION OF THE WATER RIGHT ONLY AND IS NOT INTENDED TO PROVIDE LEGAL DIMENSIONS OR LOCATIONS OF PROPERTY OWNERSHIP LINES.

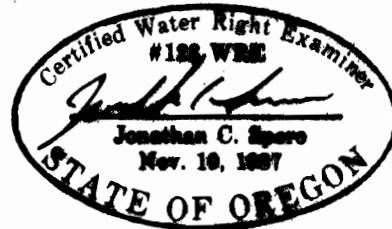

FINAL PROOF SURVEY

UNDER

APPLICATION NO. G-11716 PERMIT NO. G-10032


IN NAME OF

HERBERT A. LAJOIE, JR.

SURVEYED

JUNE 8, 1993

BY

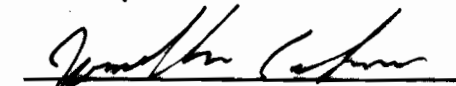
JONATHAN C. SPERO
C.W.R.E. # 123