


T.I.S., R. 4E., W.M.

22 | 23

27 | 26

1/4 CORNER

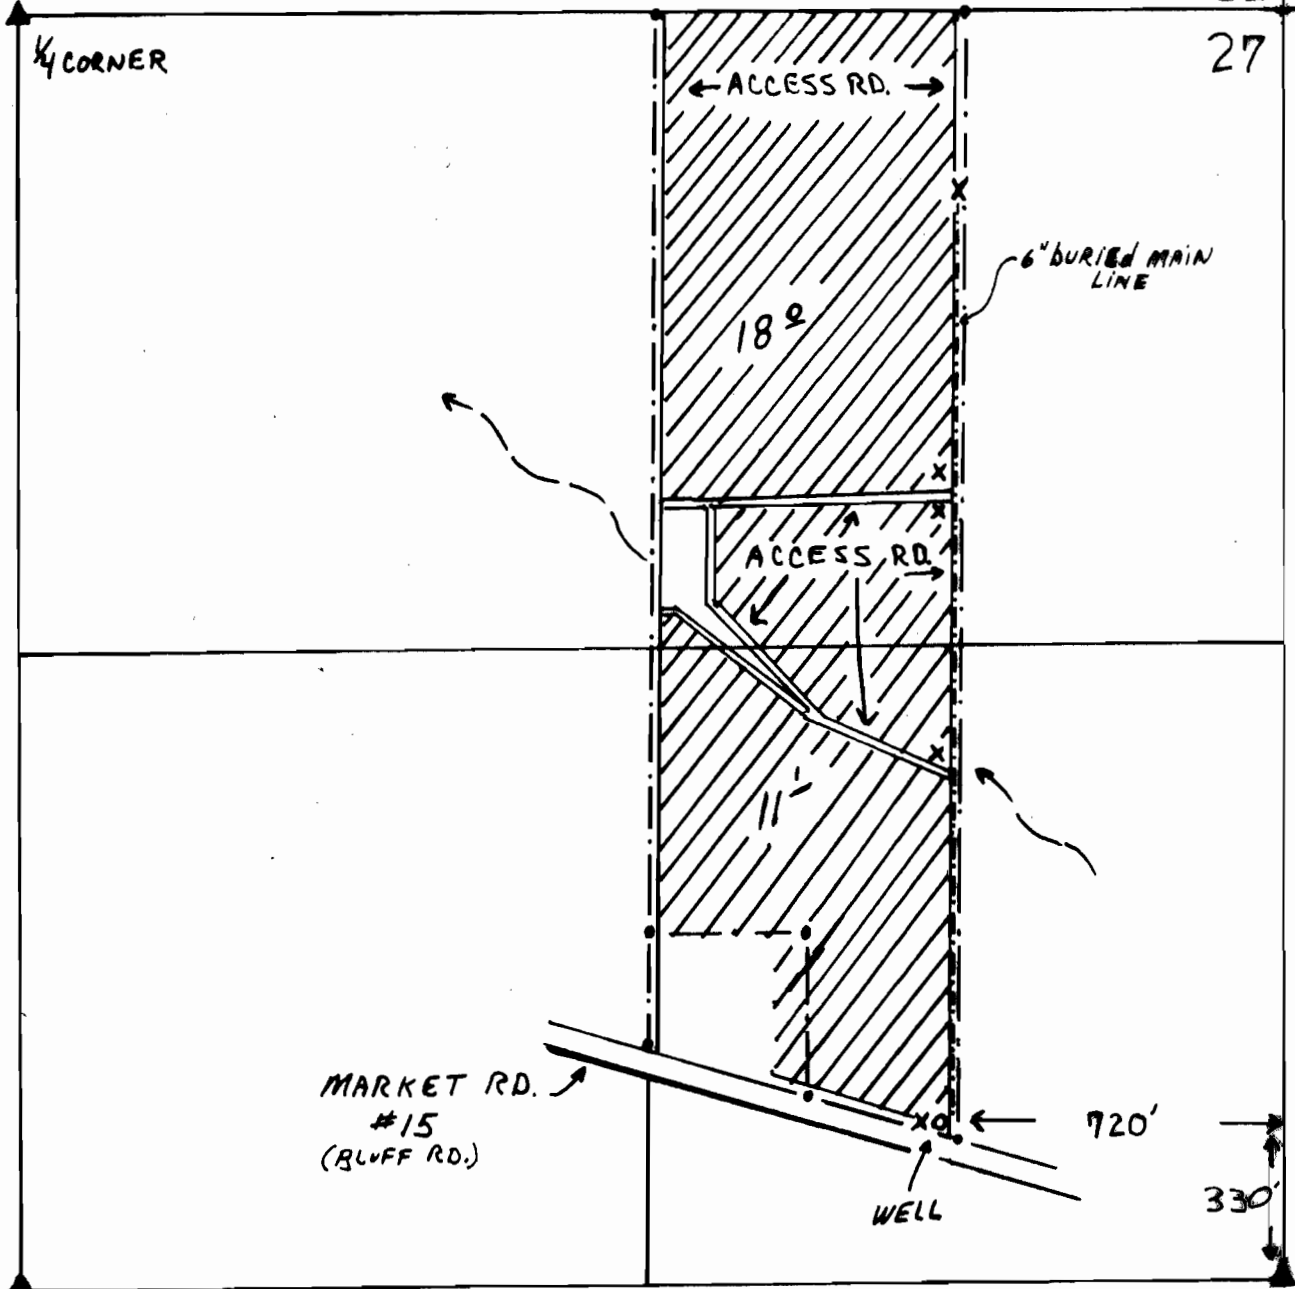


MARKET RD. #15 (BLUFF RD.)

720'

WELL

330'

1/4 CORNER

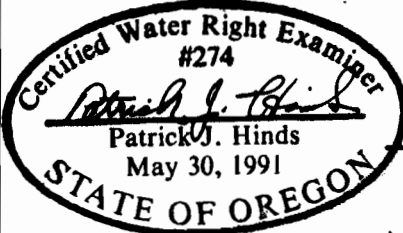

SCALE 1" = 400'

X = 3" RISER

FINAL PROOF SURVEY UNDER

APPLICATION # G-12255 PERMIT # G-11325 IN NAME OF

RICHARD SURFACE dba SURFACE NURSERY, INC.

SURVEYED NOV. 16, 1991, BY PATRICK J. HINDS

ATH