
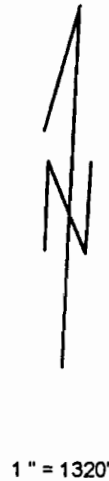


T. 10 S., R 23 E., W. M.

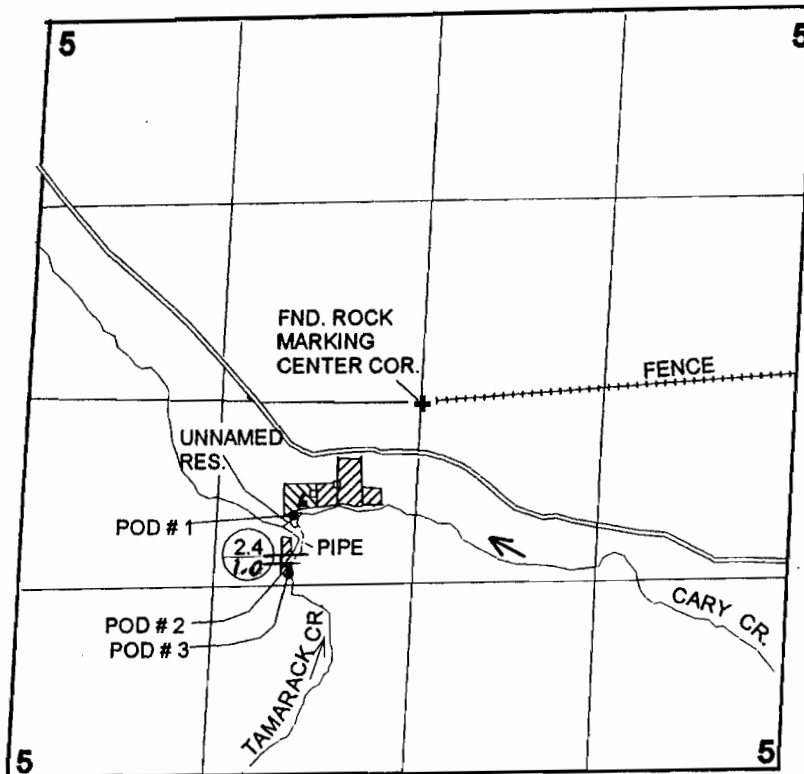

POD # 1 - CARY CREEK AND UNNAMED RESERVOIR - 860 FEET SOUTH
AND 890 FEET WEST.

POD # 2 - TAMARACK CR. - 1120 FEET SOUTH AND 920 FEET WEST.

POD # 3 - TAMARACK CR. - 1170 FEET SOUTH AND 910 FEET WEST,

ALL BEING FROM THE CENTER CORNER OF SECTION 5.

FINAL PROOF SURVEY


UNDER

Application No. R-66894
66895

Permit No. R-9252
48131

IN THE NAME OF

Surveyed: 4-02-2003 By: J. Miller

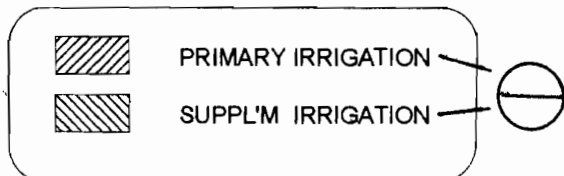

AMENDED 10/2/07
GPS & 94 SERIES AERIAL JM 4-03-2003