

**Claim of Beneficial Use
Place of Use Map**


Partial Perfection of Permit S-35551
(Application S-47453)

Townships 11 & 12 South,
Ranges 4, 5, & 6 West (W.M.)

RECEIVED

FEB 04 2008

WATER RESOURCES DEPT
SALEM, OREGON

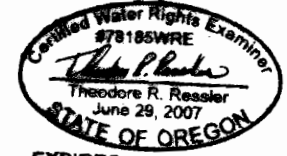

EXPIRES: 12-31-2008

Legend


- Point of Diversion (POD)
- ▨ Place of Use (POU)
(According to Permit S-35551)
- ▭ Current City Boundary
- ~ Highways
- Roads
- Railroads
- ~ Watercourses
- ⊗ Waterbodies

NOTE City water distribution system shown on separate map

Map Information
Projection: Oregon State Plane North Zone
Datum: North American Datum of 1983
Date: January 30, 2008
Prepared By: GSI Water Solutions, Inc.

Data Sources:
OWRD, City of Corvallis, Oregon Geospatial Data Clearinghouse

Disclaimer:
This map was prepared for the purpose of identifying the location of a water right only and it is not intended to provide legal dimensions or location of property ownership lines.

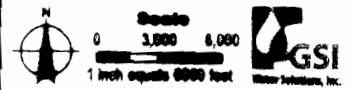

File Path: P:\272 - City of Corvallis\COBU addendum\Project_GIS\Project_mxd\COBU_POU_map_11x17.mxd

COBU MAP # 0329

Claim of Beneficial Use Point of Diversion Map

Partial Perfection of Permit S-35551 (Application S-47453)
Township 12 South, Range 5 West (W.M.)



File Path: P:\272 - City of Corvallis\COBU addendum\Project_GIS\Project_mxd\COBU_POD_map.mxd

Legend

- Point of Diversion (POD)
- Current City Boundary
- Highways
- Roads
- Watercourses
- Waterbodies

NOTE City water distribution system shown on separate map

POD Legal Description

Point of Diversion
Located 110 feet North and 350 feet East from the SW corner
of Section 12, Township 12 South, Range 5 West (W.M.)



Scale
0 660 1,320
1 inch equals 1,320 feet

Map Information
Projection: Oregon State Plane North Zone
Datum: North American Datum of 1983
Date: January 30, 2008
Prepared By: GSI Water Solutions, Inc.

Data Sources
OWRD, City of Corvallis, Oregon Geospatial Data Clearinghouse

Disclaimer
This map was prepared for the purpose of identifying the location of a water right only and it is not intended to provide legal dimensions or location of property ownership lines.



EXPIRES: 12-31-2008

