


# T. 10 S., R. 1 W., W. M.

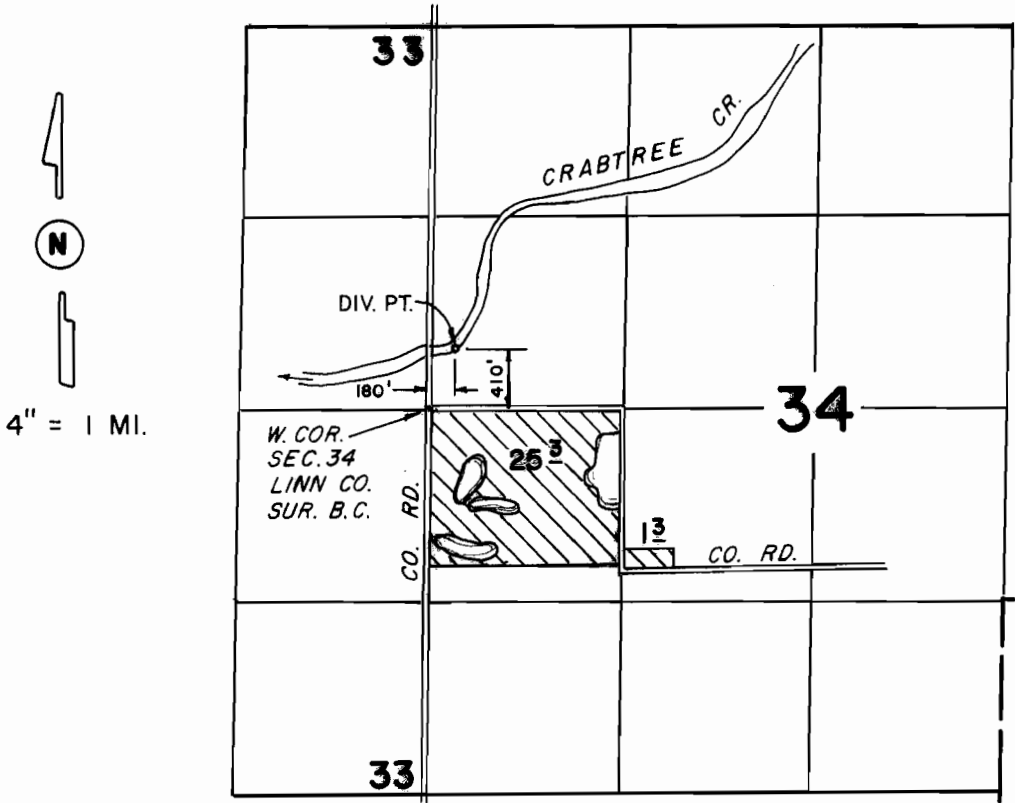


## FINAL WATER RIGHT MAP FOR WINSTON ARVEY

SURVEYED ON MARCH 16, 1994

APPLICATION 71320

PERMIT 51404

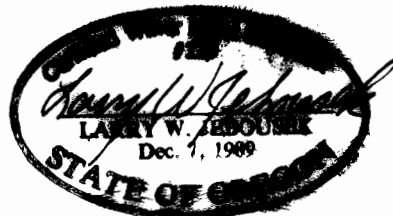

RECEIVED

APR 27 1994

WATER RESOURCES DEPT.  

THIS MAP WAS PREPARED FOR THE PURPOSE OF IDENTIFYING THE LOCATION OF A WATER RIGHT ONLY AND IS NOT INTENDED TO PROVIDE LEGAL DIMENSIONS OR LOCATION OF PROPERTY OWNERSHIP LINES.

WRD-Application & Permit numbers Added 3/18/08