






T.9S.R.1W.W.M.

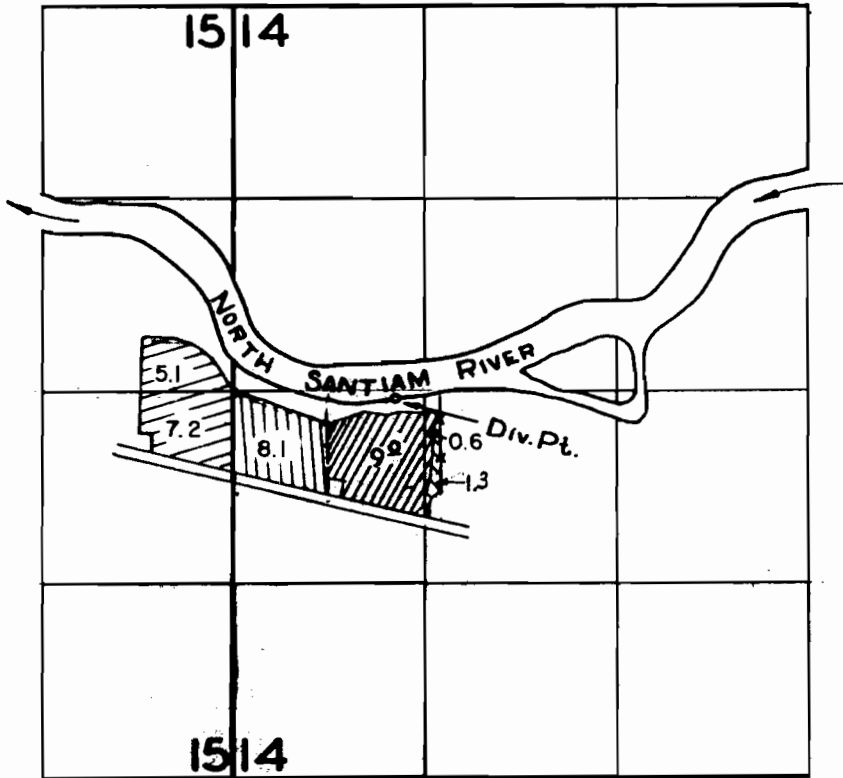

4" = 1 MI.



DIV. PT. LOC. 1120' E. & 50' S. FROM THE 1/4 COR. ON THE EAST LINE OF SEC. 15

-  C-28449 (SUPPLEMENTAL FROM DETROIT RESERVOIR)
-  PRIMARY - RANDY FERY (N. SANTIAM RIVER & RESERVOIR)
-  GRANDFATHER (N. SANTIAM RIVER & RESERVOIR)
-  FATHER - (N. SANTIAM R. & RES.)

FINAL

WATER RIGHT MAP FOR

RANDY FERY

THIS MAP WAS PREPARED FOR THE PURPOSE OF IDENTIFYING THE LOCATION OF A WATER RIGHT ONLY AND IS NOT INTENDED TO PROVIDE LEGAL DIMENSIONS OR LOCATION OF PROPERTY OWNERSHIP LINES.

SURVEYED ON SEPTEMBER 4, 1991

BY: *Sheryl J. Edwards*

