

RECEIVED

FEB 03 2003



WATER RESOURCES DEPT.
SALEM, OREGON

WATER RESOURCES DEPARTMENT
APPLICATION MAP
Section 27-28, T1N,R5E, W.M.

JOHN & GARY MILLER
3255 NE HENDERSON ROAD
CORBETT, OR 97019

SCALE: 1" = 400'

0' 200' 400'

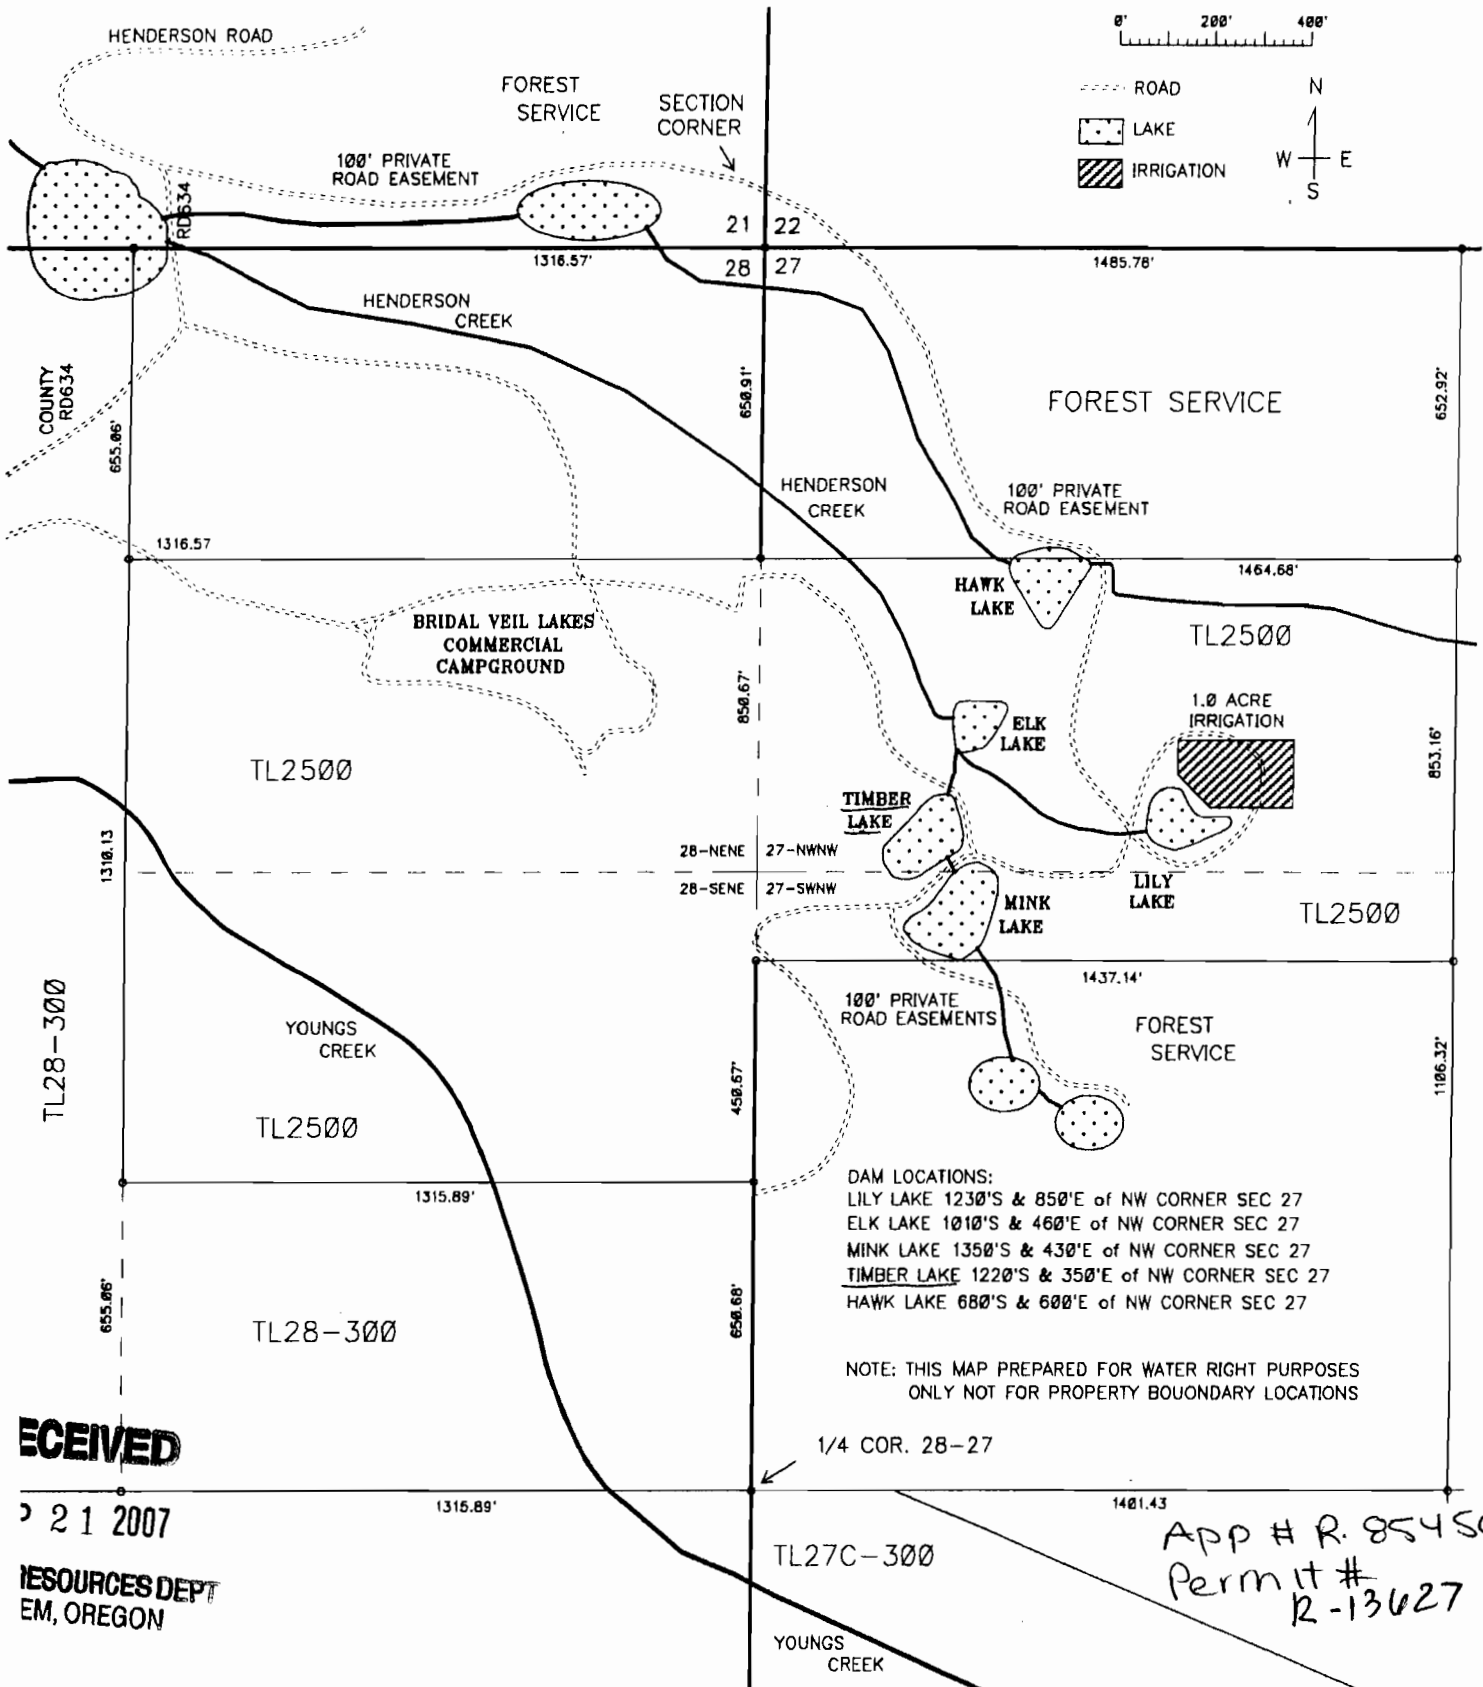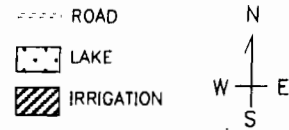

RECEIVED

21 2007

WATER RESOURCES DEPT.
SALEM, OREGON

App # R. 85450
Permit #
R-13627