

SECTION 30 T.15, R.3W., W.M.
WASHINGTON COUNTY, OREGON

PREPARATION OF THIS MAP IS FOR THE PURPOSE OF IDENTIFYING THE LOCATION OF THE WATER RIGHT ONLY THERE IS NO INTENT TO PROVIDE DIMENSIONS OR CORNER OR PROPERTY OWNERSHIP LINES.


Application No R-69786 + 69787
Permit No.

SCALE: 1"=400'

FINAL PROOF SURVEY
SURVEYED: 5/21/1995
PERMIT NO'S R-11185, 50805



- NON-PRODUCTION BLDGS
- CONTAINERS, FIELD CROPS & HOOP HOUSES

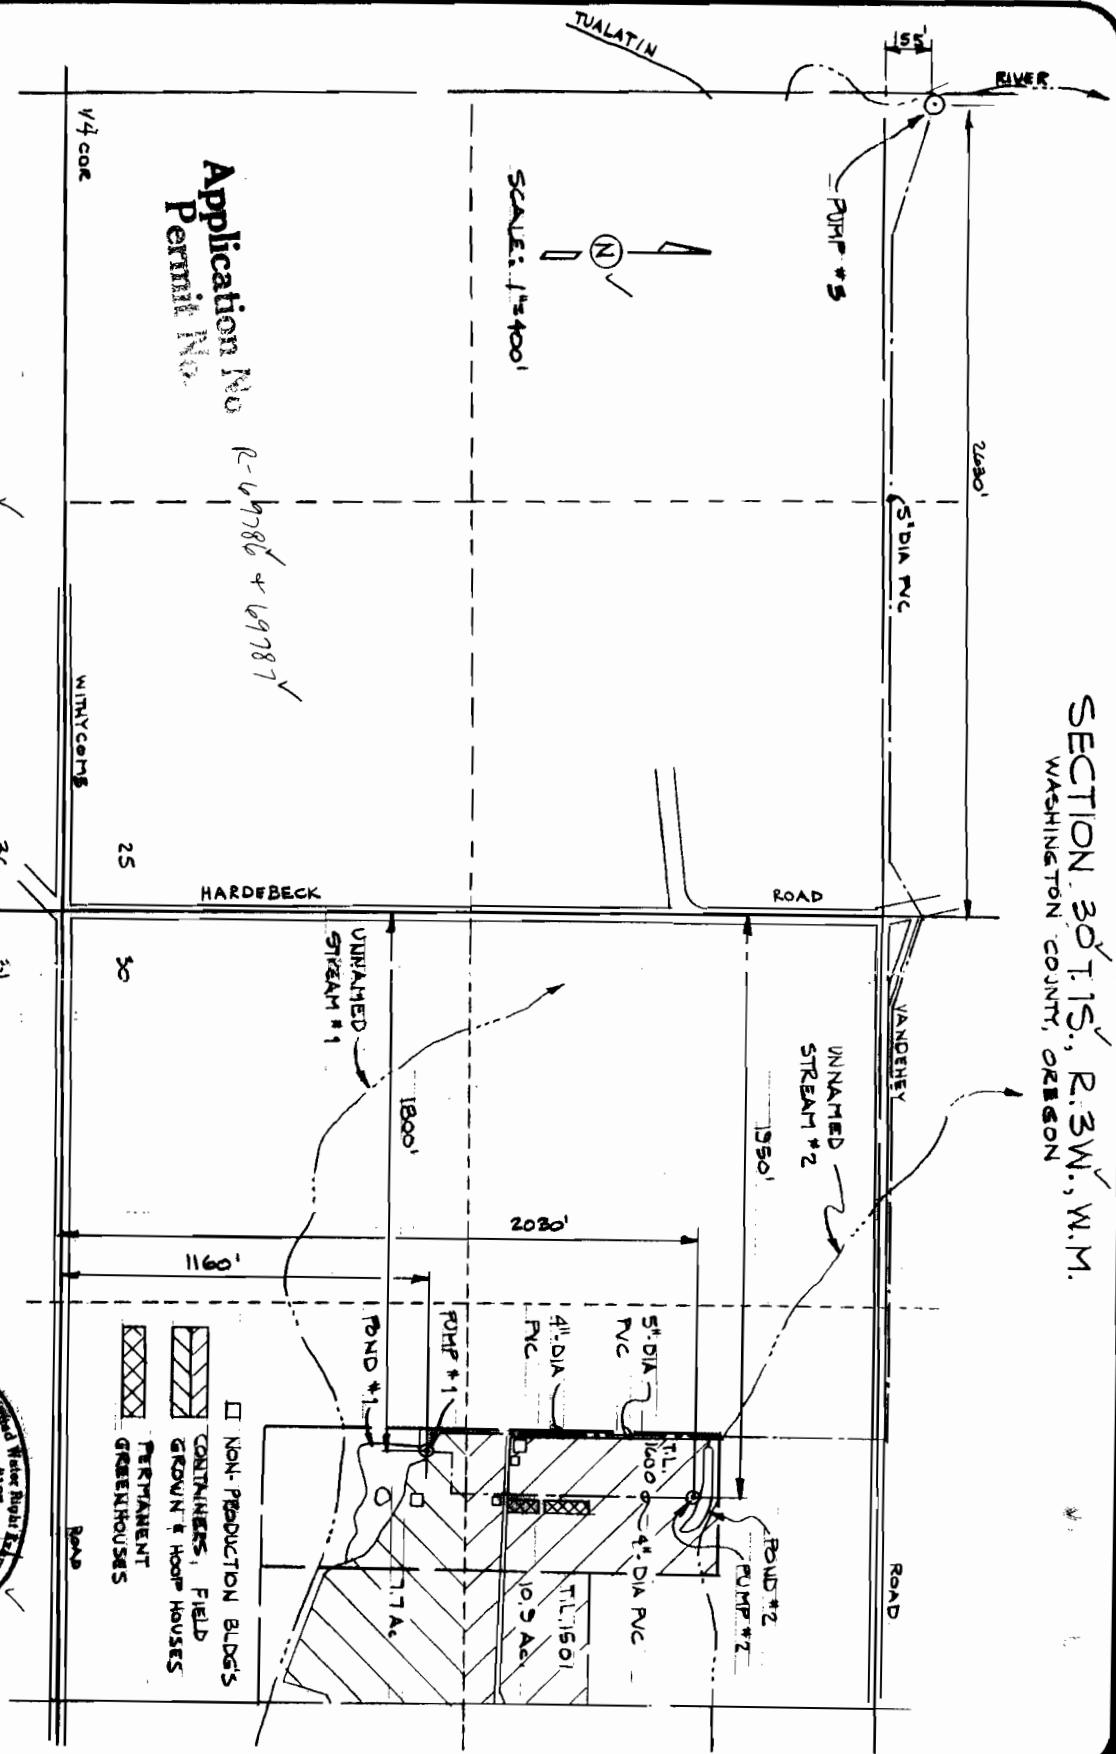

VERBOORT ENGINEERING
AGRICULTURE • CIVIL • WATER RESOURCES
HILLSBORO, OREGON

by date
designed WRV 9-7-93
drawn JER 9-7-93
checked WRV 9-7-93
drawing no. 93-B-18
sheet no. 1/1

TALON & LISA BUCHHOLZ
41840 S.W. VANDEHEY RD.
GASTON, OR 97119