


CLAIM OF BENEFICIAL USE MAP

UNDER APPLICATION R-85401 ; PERMIT R-14018

SW1/4 SW1/4 SEC 26 T 22S R 45E W.M.


U.S.G.S. QUAD - DWYHEE RIDGE, OREG. - 7 1/2'

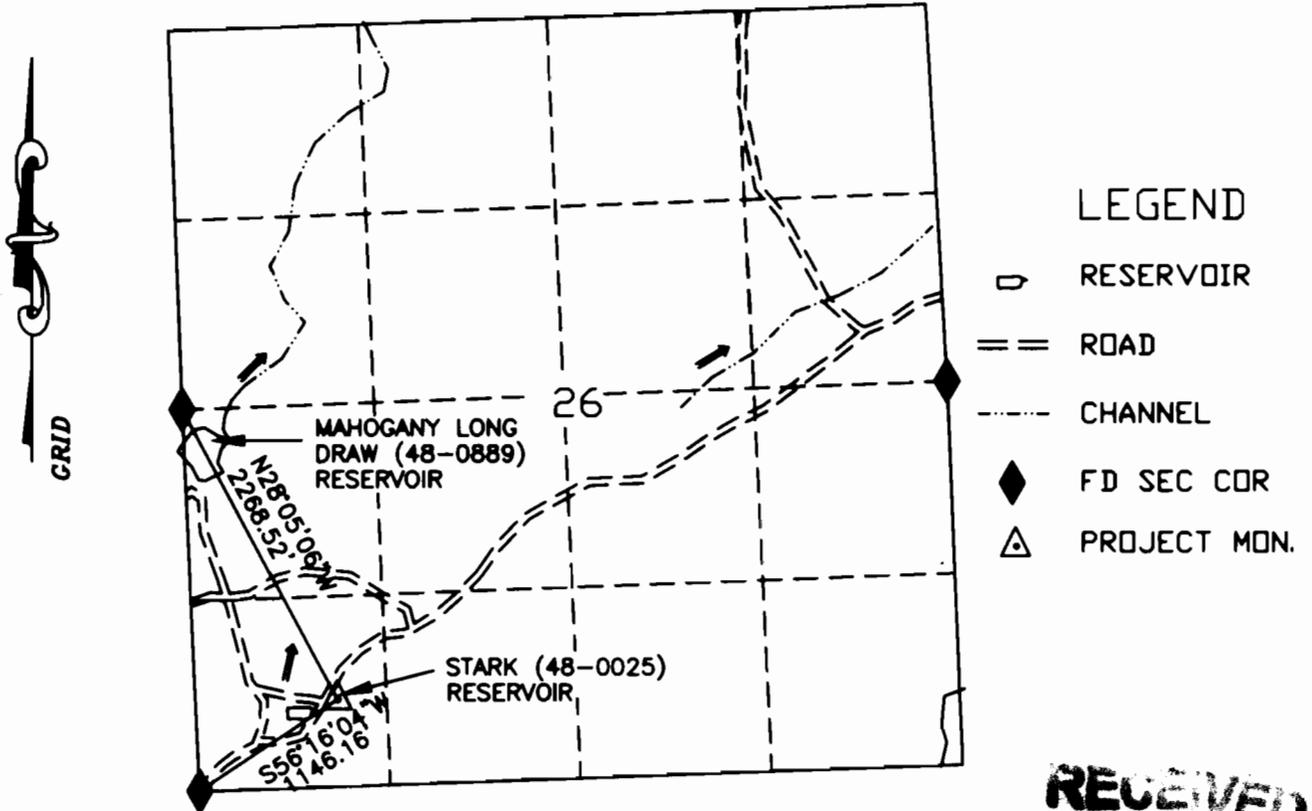

RECEIVED
 SE- 10 2007
 WATER RESOURCES DEPT
 SALEM OREGON

STARK (48-0025) RESERVOIR

ASSESSORS MAP 22S45E
 TAX LOT 100

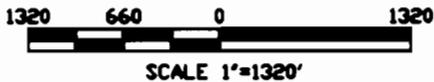

I, Charles E. Joy, Administrative Officer, Vale BLM agree to the findings of the CWRE and do submit this site report and map as my Claim of Beneficial Use of the water as provided under the terms and conditions of my Permit R-14018

Charles E. Joy



THIS MAP IS FOR THE PURPOSE OF LOCATING A WATER RIGHT AND IS NOT INTENDED TO PROVIDE LEGAL DIMENSIONS FOR LOCATION OF PROPERTY BOUNDARIES.

ACAD:CG
 DWG FILE:STARK-BENE

UNITED STATES DEPARTMENT OF THE INTERIOR BUREAU OF LAND MANAGEMENT DIVISION OF OPERATIONS VALE DISTRICT	
STARK (48-0025) RESERVOIR	
DESIGNED:	<i>Thomas J. [Signature]</i>
REVIEWED:	<i>[Signature]</i>
APPROVED:	<i>Charles E. Joy</i> ADMINISTRATIVE OFFICER
DRAWN:	CG
DATE:	11/22/06
SCALE:	1"=1320'
SHEET:	1 OF 1
DRAWING NO.:	DR=03-9172.45-1285