


# CLAIM OF BENEFICIAL USE MAP

UNDER APPLICATION R-85405 ; PERMIT R-13583

SW1/4 NE1/4 SEC 19 T 19S R 45E W.M.

U.S.G.S. QUAD - VALE WEST, OREG. - 7 1/2'

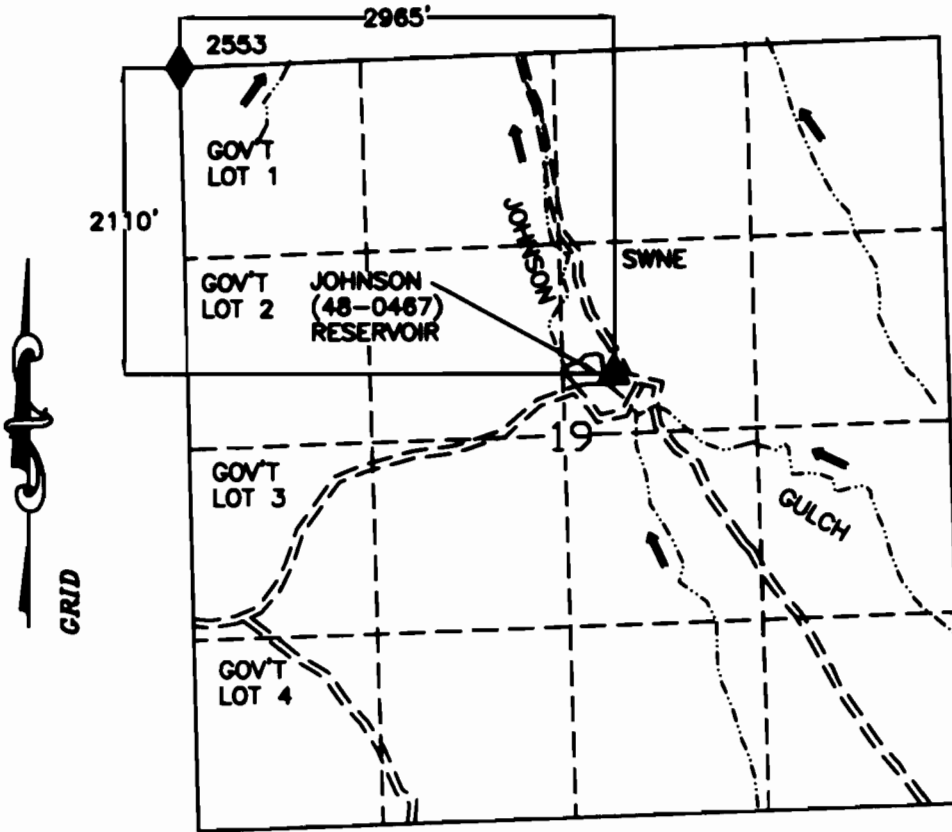


## LEGEND

- RESERVOIR
- ROAD
- CHANNEL
- FD SEC COR
- PROJECT MON.

## JOHNSON (48-0467) RESERVOIR

ASSESSORS MAP 19S45E  
TAX LOT 100

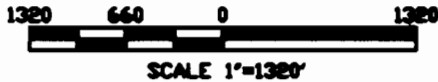

I, Charles E. Jazl, Administrative Officer, Vale BLM agree to the findings of the CWRE and do submit this site report and map as my Claim of Beneficial Use of the water as provided under the terms and conditions of my Permit R-13583

*Charles E. Jazl*



THIS MAP IS FOR THE PURPOSE OF LOCATING A WATER RIGHT AND IS NOT INTENDED TO PROVIDE LEGAL DIMENSIONS FOR LOCATION OF PROPERTY BOUNDARIES.

**RECEIVED**

SEP 10 2007

WATER RESOURCES DEPT  
SALEM OREGON

UNITED STATES DEPARTMENT OF THE INTERIOR  
BUREAU OF LAND MANAGEMENT  
DIVISION OF OPERATIONS VALE DISTRICT

### JOHNSON (48-0467) RESERVOIR

DESIGNED: *William P. [Signature]*  
REVIEWED: *Donald W. [Signature]*  
APPROVED: *Charles E. Jazl*

DRAWN: CG SCALE: 1"=1320'

DATE: 11/21/2006 SHEET 1 OF 1

DRAWING NO. DR-03-9172.45-1275