

T. 37 S., R. 6 W., W.M.
SECTION 13 SW 1/4, NE 1/4


THIS MAP IS FOR THE PURPOSE OF IDENTIFYING THE LOCATION OF THE WATER RIGHT ONLY AND IS NOT INTENDED TO PROVIDE LEGAL DIMENSIONS OR LOCATIONS OF PROPERTY OWNERSHIP LINES.



SCALE: 1" = 400'

2000

11 23 00

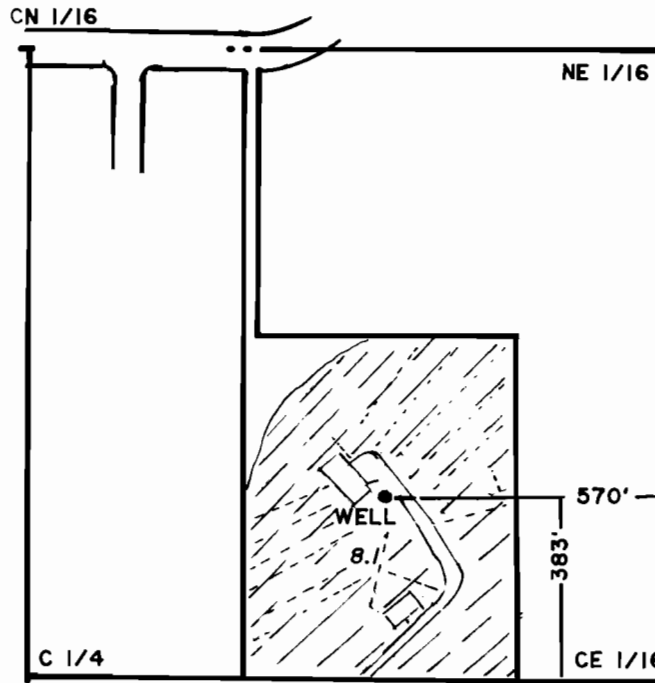

WATER RESOURCES DEPT
SALEM, OREGON

----- INDICATES LOCATION
OF BURIED PVC PIPE

FINAL PROOF SURVEY

UNDER

APPLICATION NO. G-12018 PERMIT NO. G-11046

IN THE NAME OF

PATRICK J. AND KATHLEEN M. KELLY

SURVEYED JUNE 18, 1993 BY

JONATHAN C. SPERO
C.W.R.E. # 123