


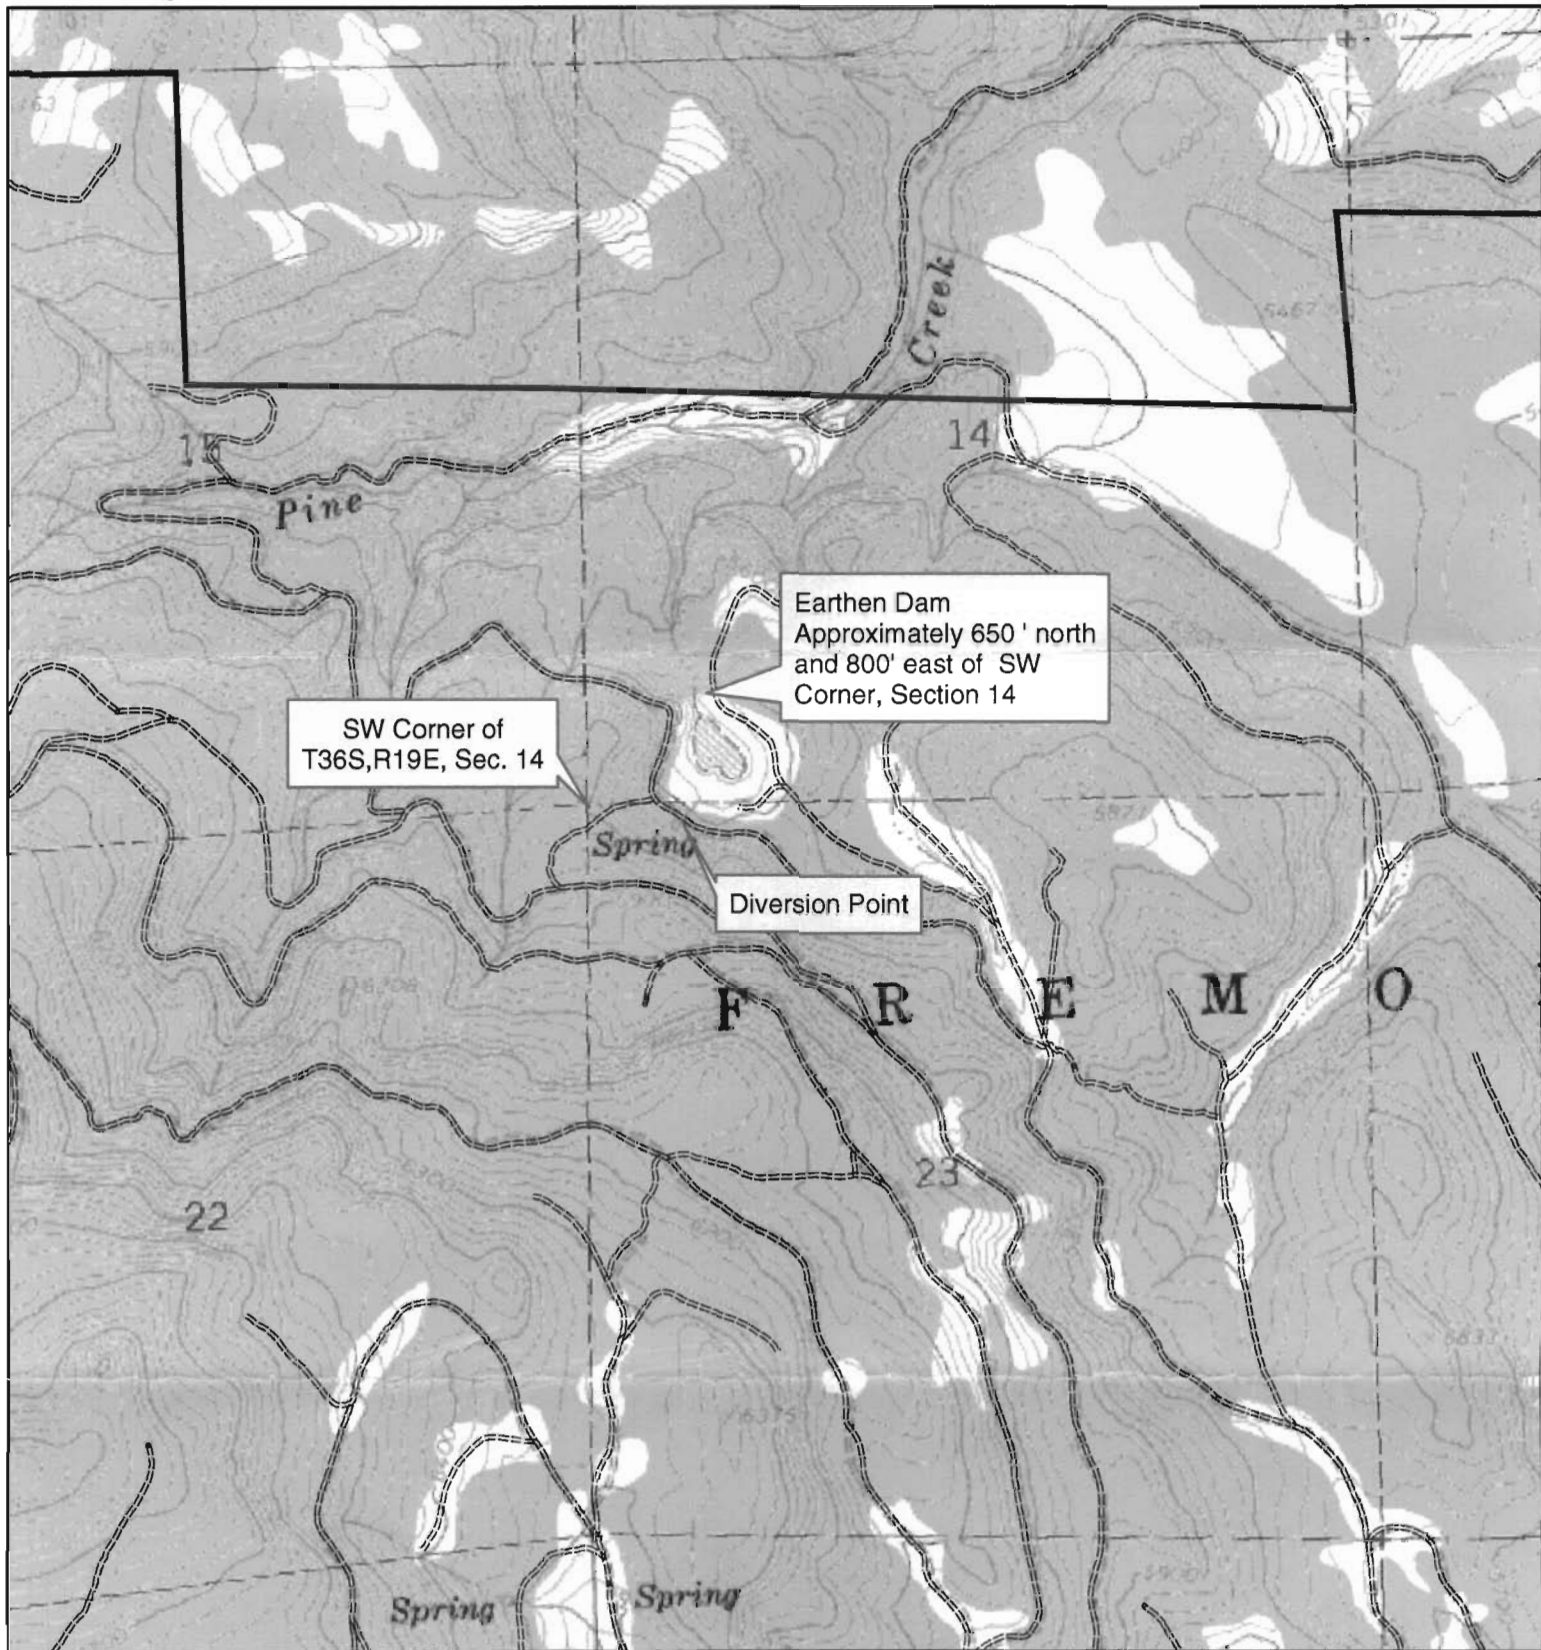

Collins Timber Company
Claim of Beneficial Use for
Reservoirs Storing less than 9.2 Ac/Ft

App # R-86074
Permit # R-14083
Portions of T36S,R19E,Sec. 14,SE,SW,SW1/4

RECEIVED

OCT 16 2007

WATER RESOURCES DEPT
SALEM, OREGON



0 350 700 1,400 2,100 2,800
Fet