RECEIVED
SEP 26 2007
WATER RESOURCES DEPT
SALEM, OREGON

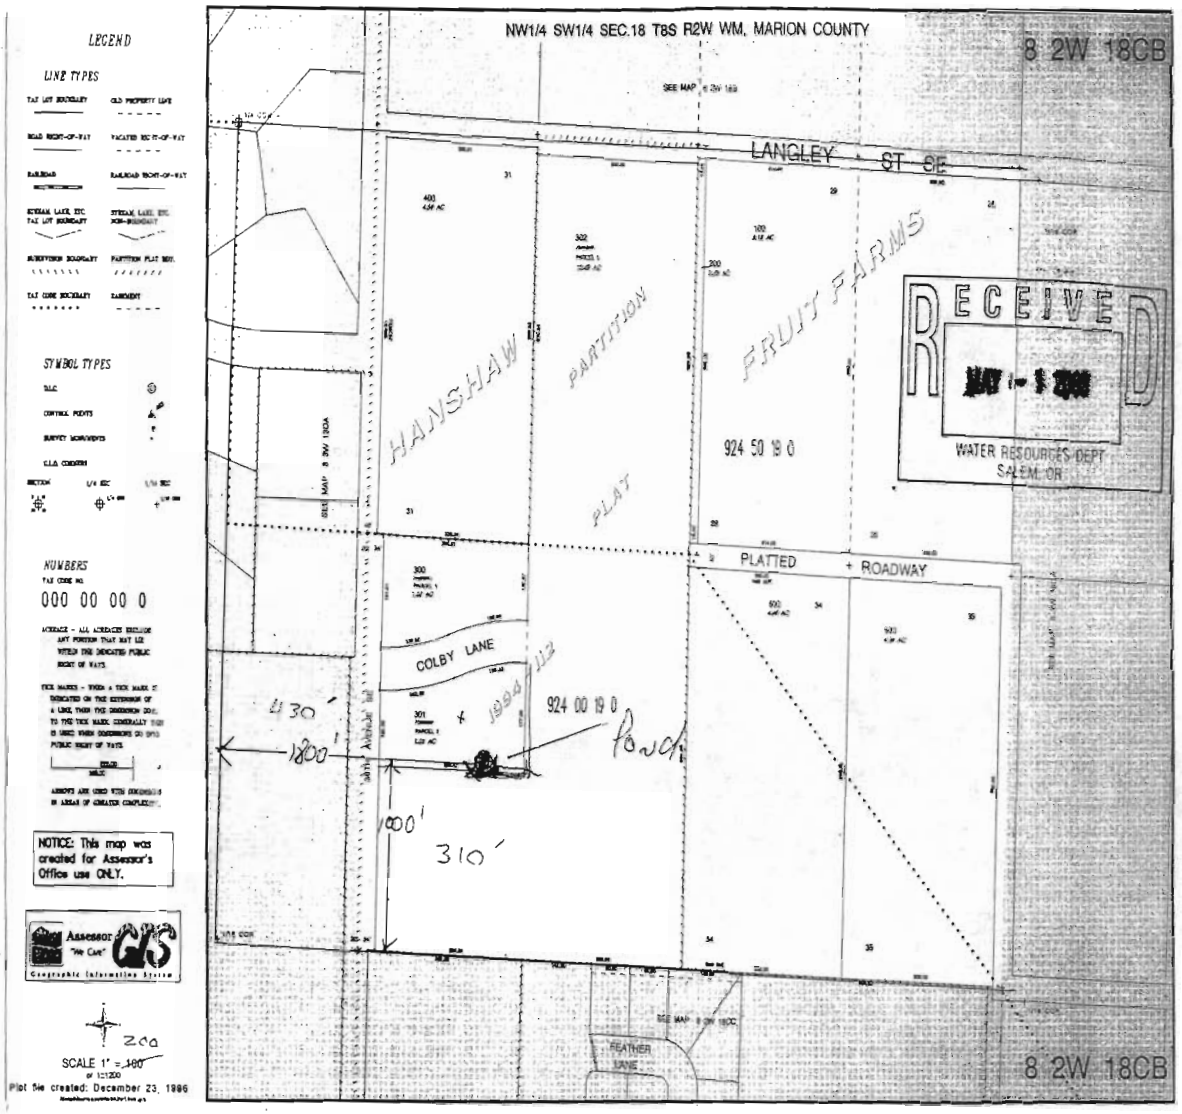

Approx SCALE
1" = 200 FT.

App no R-85578 Permit No R-13713