



# T.6S., R.4W., W.M.

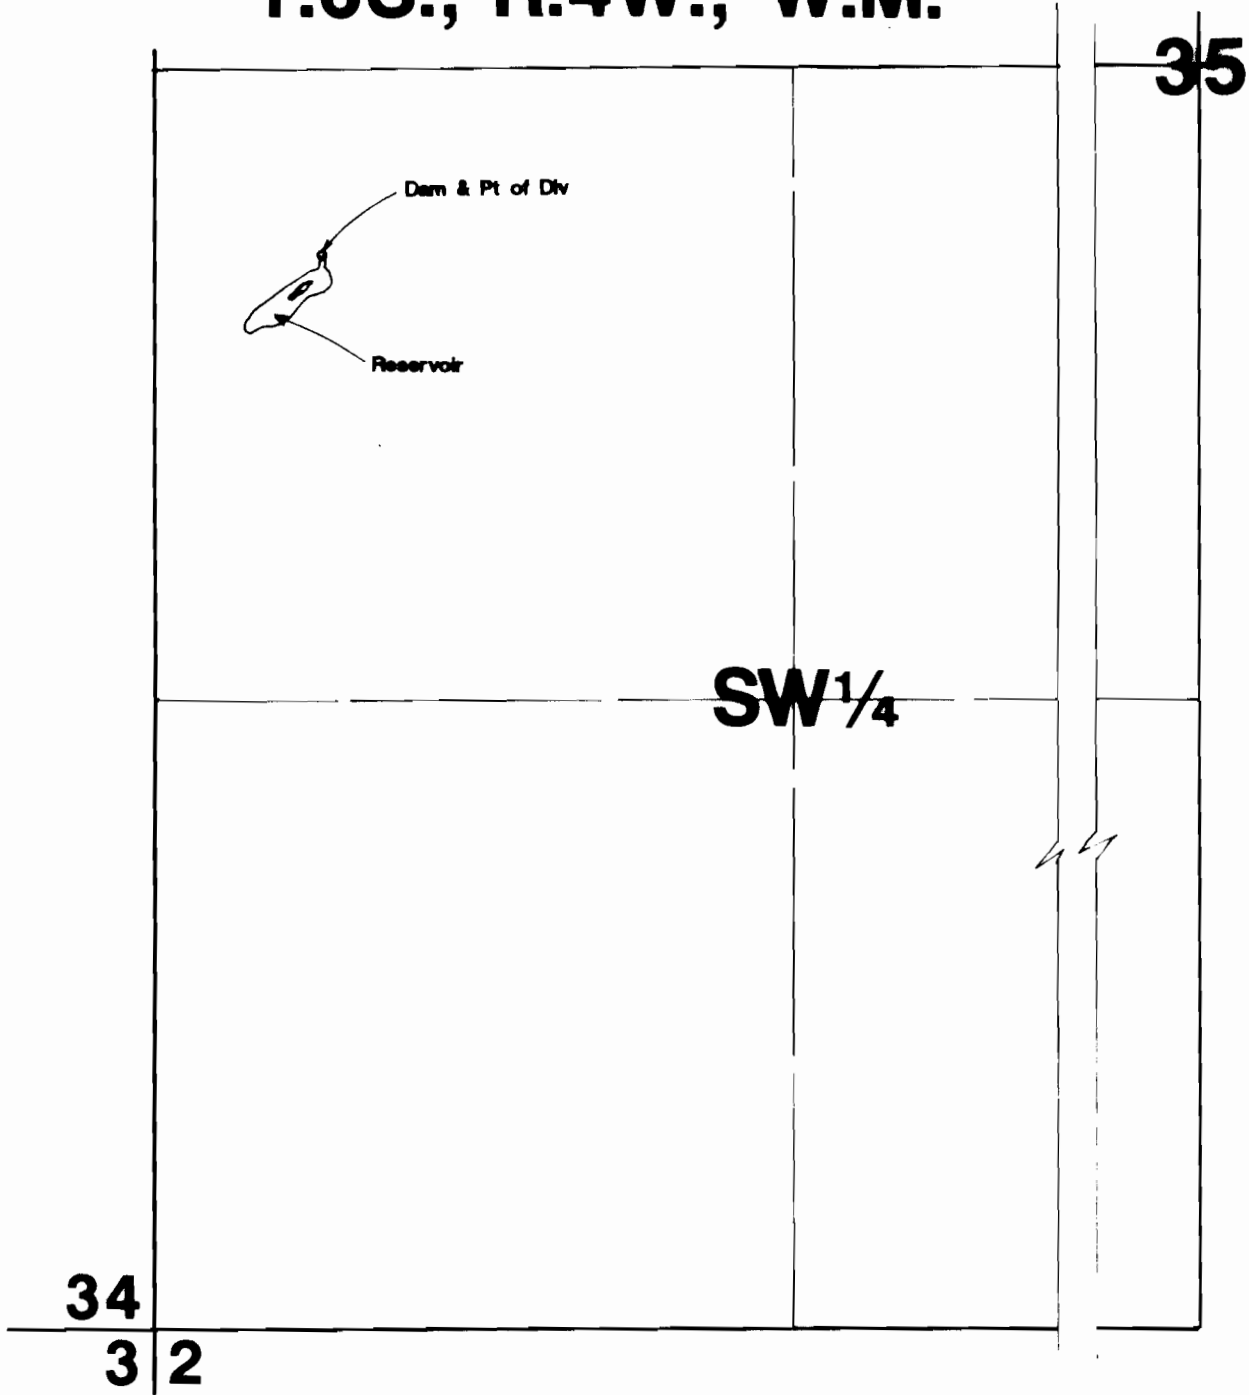

Dam & Pt of Div located 2250'N & 350'E from SW corner Section 35.

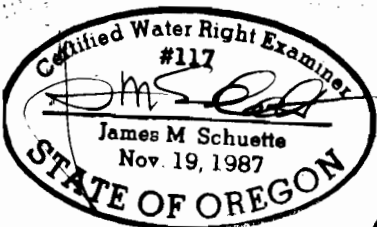

## Final Proof Survey

Application #: R-70498 Permit #: R-11354

In Name Of

# Oregon 4-H Conf. & Ed. Center

Surveyed on May 27, 1994 by JM Schuette

THIS MAP WAS PREPARED FOR THE PURPOSE OF IDENTIFYING THE LOCATION OF A WATER RIGHT ONLY AND IS NOT INTENDED TO PROVIDE LEGAL DIMENSIONS OR LOCATION OF PROPERTY OWNERSHIP LINES

MODIFIED BY WRD STAFF, 3/24/08 JWS