


T24S, R34E, WM

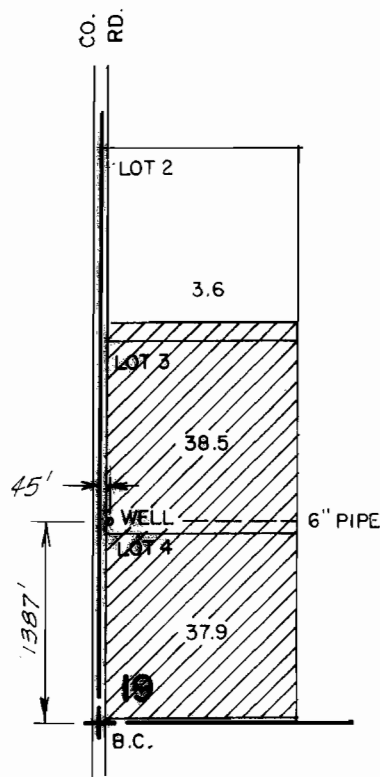

THE PURPOSE OF THIS MAP IS TO
IDENTIFY THE LOCATION OF THE
WATER RIGHT. IT IS NOT INTENDED
TO PROVIDE INFORMATION RELATIVE
TO THE LOCATION OF PROPERTY
OWNERSHIP.

	FINAL PROOF SURVEY UNDER APPLICATION NO. G-12283 PERMIT NO. G-11697			IN THE NAME OF CLARENCE PHILLIS	
	Scale: 4" = 1 MILE	Date: AUG 1994	Job: 1151		
	Dsn:	M. A. PALMER & SONS, INC. ENGINEERING & SURVEYING 254 N. Alder - Box 61 Burns, Oregon 97720	Sht. No.		
	Drn: CHRIS		of <u>1</u>		
	Ckd:				