


RECEIVED

SEP - 1 1994

WATER
SALEM, OREGON


FINAL PROOF SURVEY
FOR
APPLICATION No. 71583
TILLAMOOK COUNTY, OREGON

NOTE: SEE NARRATIVE FOR DESCRIPTION OF WATER SYSTEM.

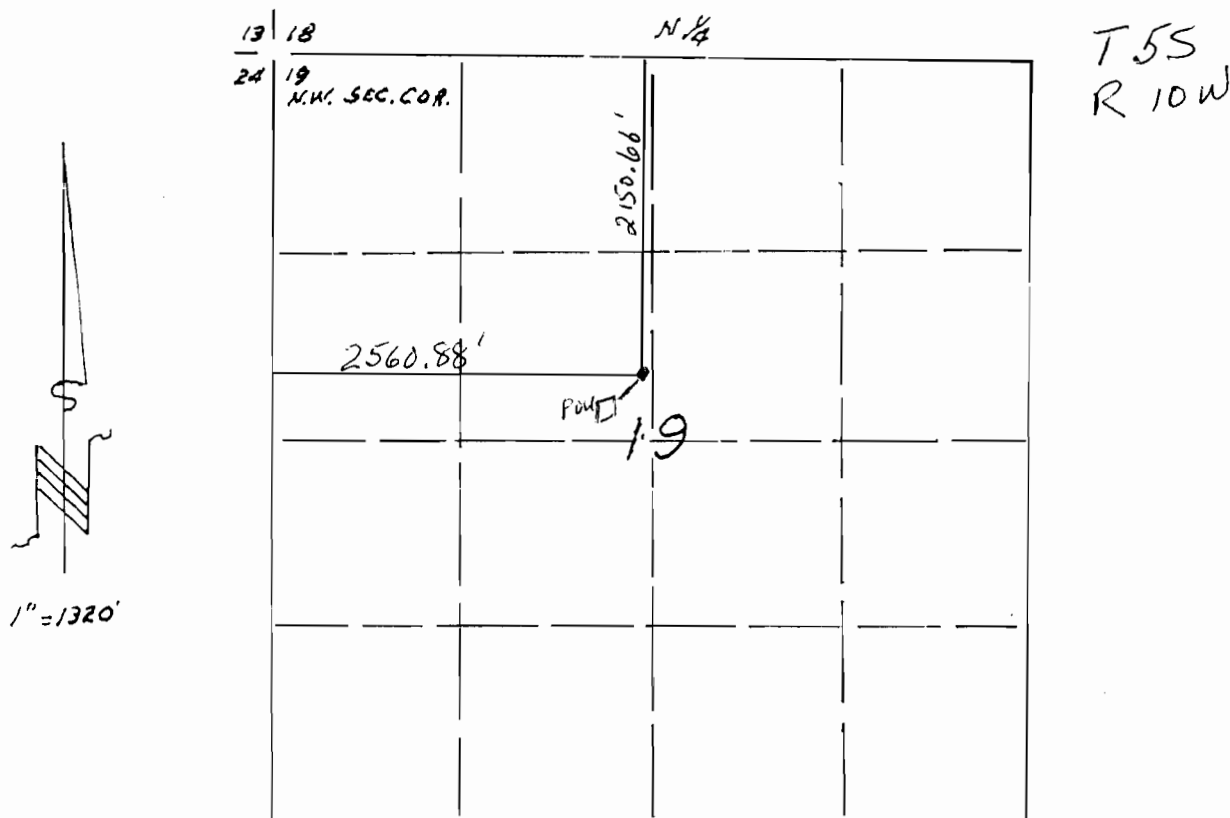

CERTIFICATE:

THE FINAL PROOF SURVEY AND INSPECTION OF THE USE WAS FOUND TO BE COMPLETED UNDER THE TERMS AND CONDITIONS OF PERMIT No. 71583 BY ME ON 7 JULY 1994 AND THE FACTS CONTAINED ON THIS MAP, THE FINAL PROOF SURVEY NARRATIVE AND THE WRITTEN FINAL PROOF STATEMENT ARE CORRECT TO THE BEST OF MY KNOWLEDGE.

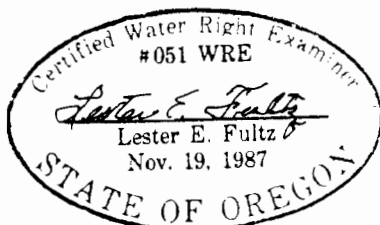

Lester E. Fultz
C.W.R.E. No. 051

MODIFIED BY WRD STAFF 3-27-08 JWG
Spring POU entered from report data.

L. E. FULTZ
11 JUL 94