


T. 19 S., R 33 E., W. M.

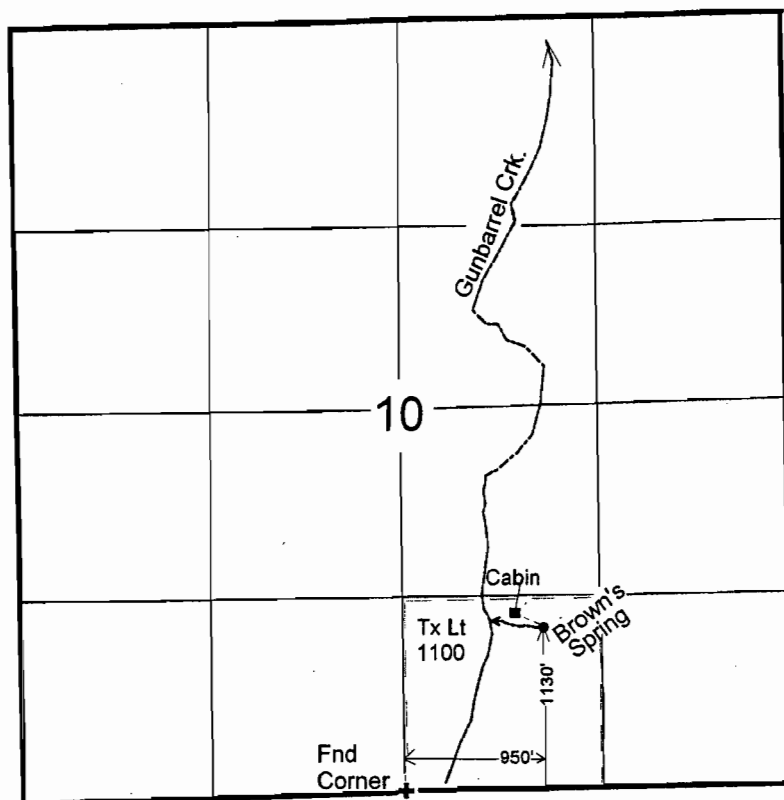

1" = 1320'

FINAL PROOF MAP
under
Application 61067 Permit 45526

IN THE NAME OF

GEORGE I.
and
MARY ELLEN BROWN

Surveyed: October 06, 2004 by: J. Miller

aerial photo and gps
11/27/2007 JM

AMENDED 1/15/08 LHM