


FINAL PROOF MAP

T.12S., R.1W., SECTIONS 20 & 29

APPLICATION NO. 70207 PERMIT NO. 51335

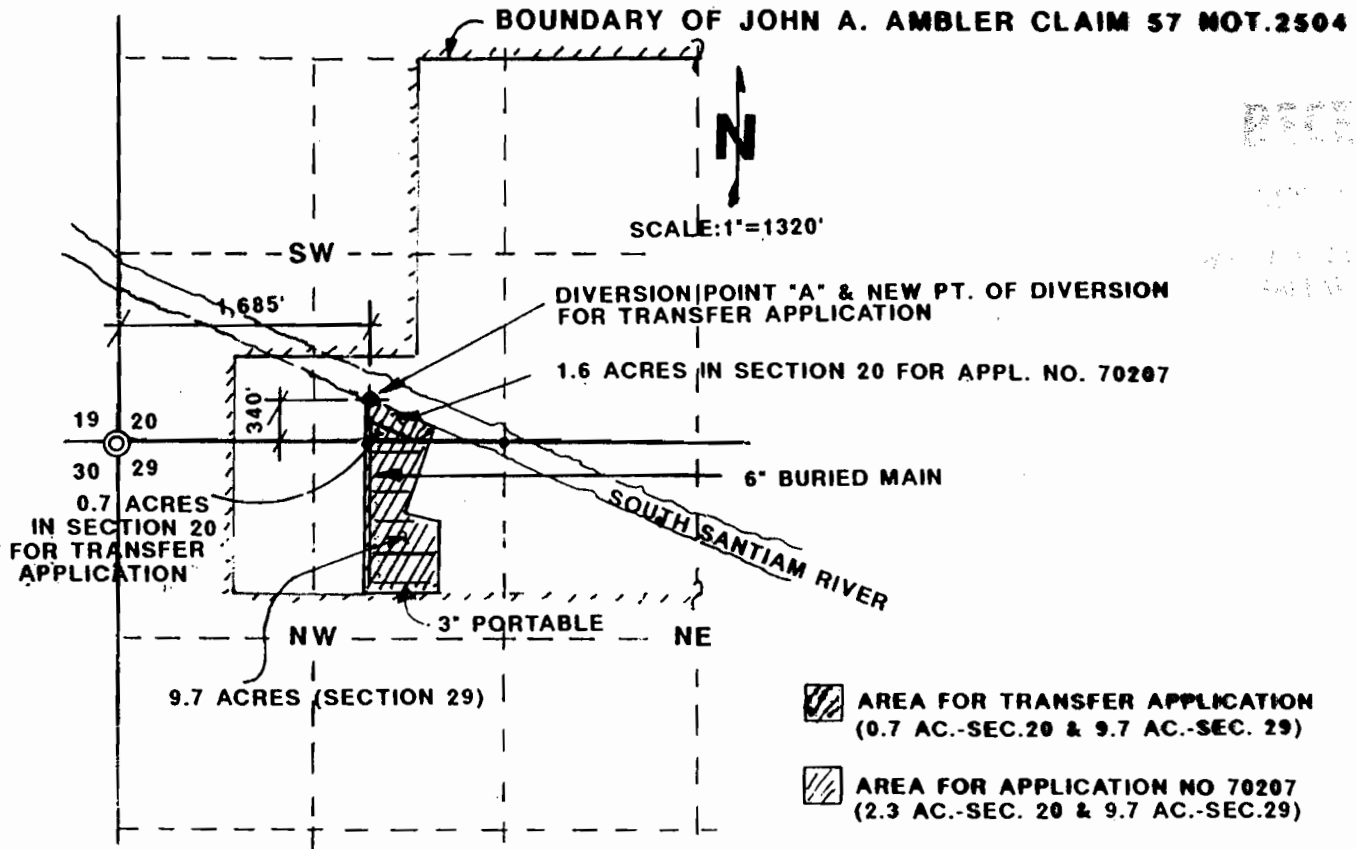


RECEIVED

APR 11 1993

WATER RIGHTS DIVISION

DIVERSION PT. "B" MAP
SECTION 27, T.13S., R.1E., W.M.

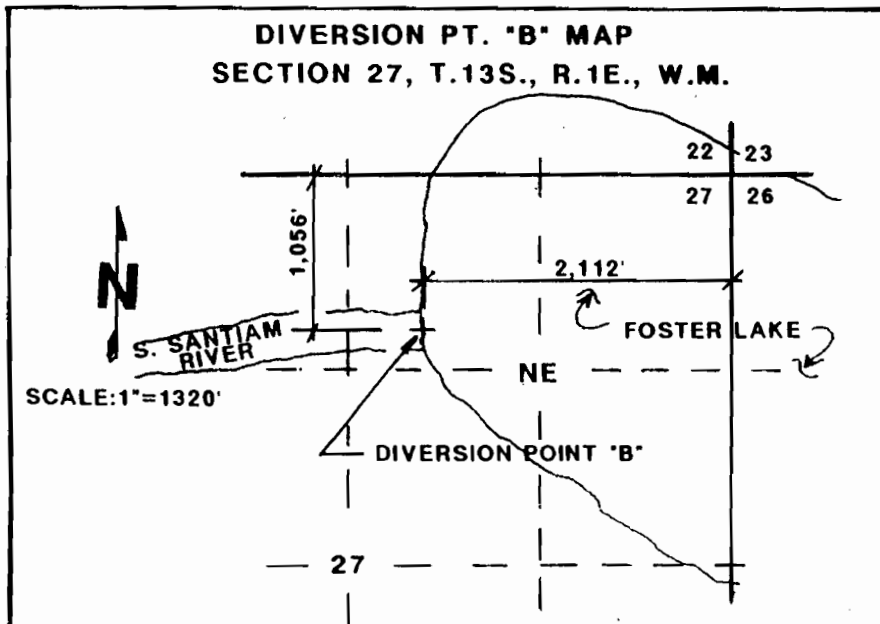

Exp 12-31-93

NOTE: Map is for the purpose of identifying location of water right and has no intent to dimension or locate property ownership lines.