
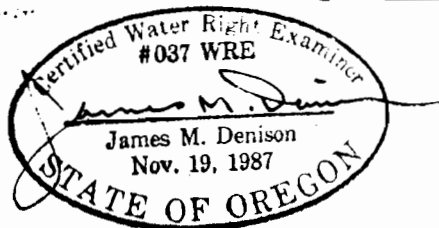


RECEIVED

OCT 04 1994

WATER RESOURCES DEPT
SALEM, OREGON

T10S. R10W., W.M.
SECTION 31
LINCOLN COUNTY, OREGON

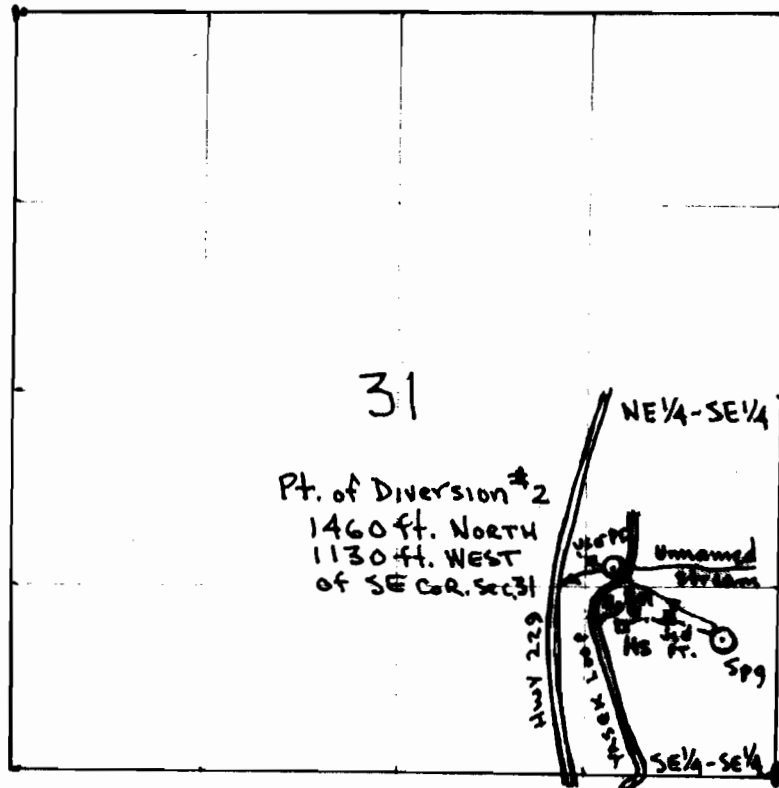

FINAL PROOF SURVEY
UNDER

Scale: 1 in. = 1320 ft.

APPLICATION #70395

51374
PERMIT # S4374

IN THE NAME OF

ANTHONY J. & DOROTHY E. FIEBER

SURVEYED: SEPTEMBER 29, 1994

BY: J. M. DENISON

MODIFIED BY WRD STAFF 4-1-08 TWX
THIS MAP PREPARED SOLEY FOR THE PURPOSE OF SHOWING LOCATION OF A WATER RIGHT, AND IS
NOT INTENDED FOR USE FOR PROVIDE DIMENSIONS OR LOCATION OF PROPERTY OWNERSHIP
LINES.