

**FINAL PROOF
MAP**

**WATER RIGHT PERMIT NO. 51394
SEPTEMBER 23, 1993**



SW 1/4, NE 1/4 SEC. 34, T19S, R12W, W.M.
LANE COUNTY, OREGON

FOR: PHILLIP C. BROWN
P.O. BOX 35
WESTLAKE, OR 97493

PREPARED BY: WOBBE & ASSOCIATES, INC.
510 KINGWOOD ST./P.O. BOX 1136
FLORENCE, OR 97439

RECEIVED

SEP 27 1993
WATER RESOURCES DEPT.
SALEM, OREGON

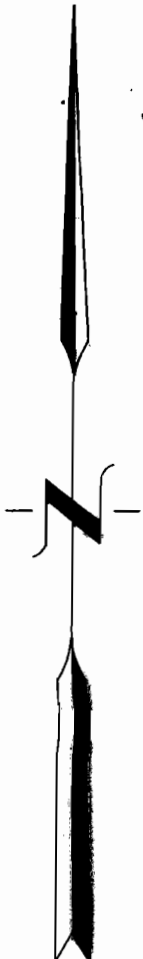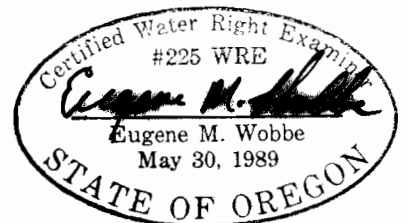

SCALE
1" = 400'

AMENDED BY WRD STAFF, 4-2-08 *jug*