

RECEIVED

SEP 13 1993

WATER RESOURCES DEP  
SALEM, OREGON

# FINAL PROOF MAP

T.12S., R.1W., SECTION 20

APPLICATION NO. 71133


PERMIT NO. 51295

18 17  
19 20



SCALE: 1"=400'

NW

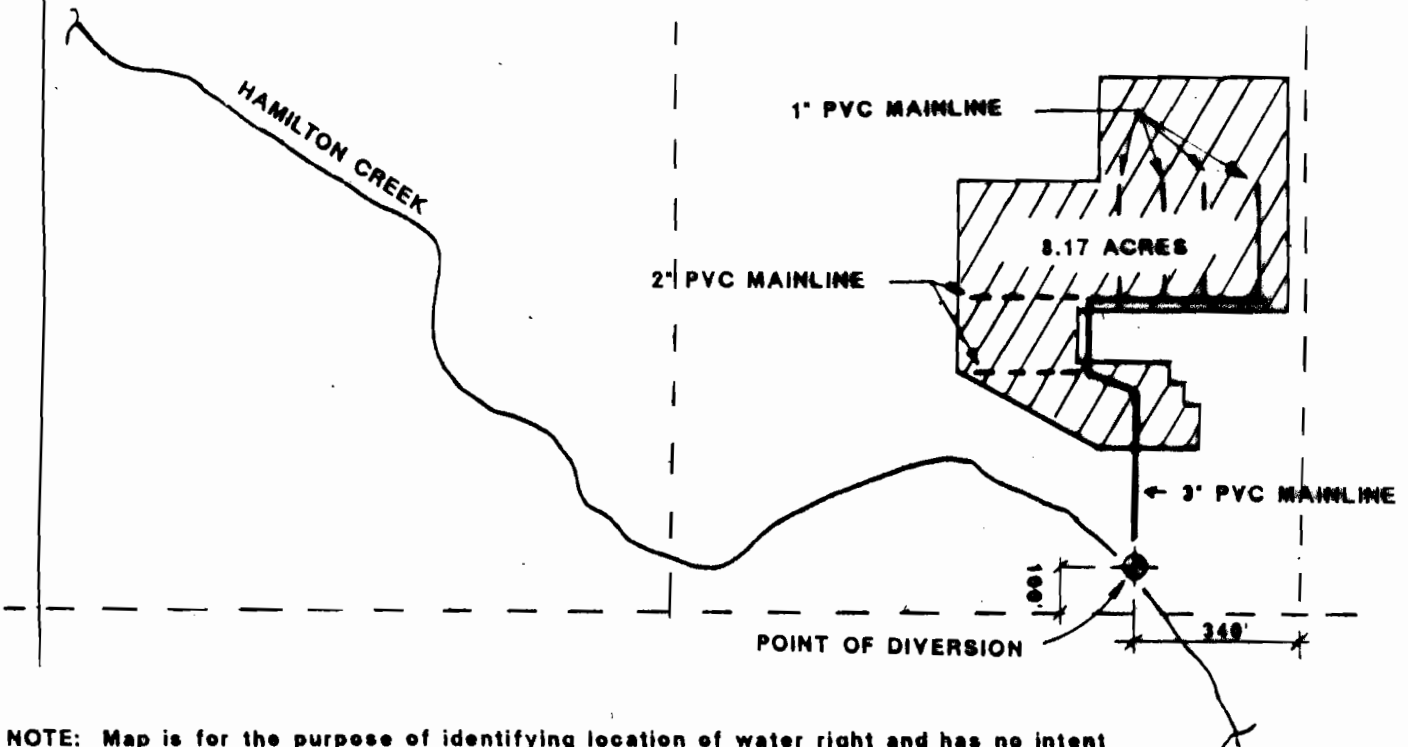

NOTE: Map is for the purpose of identifying location of water right and has no intent to dimension or locate property ownership lines.