


SECTION 30 & 31, T.6S., R.5W., W.M.
POLK COUNTY, OREGON

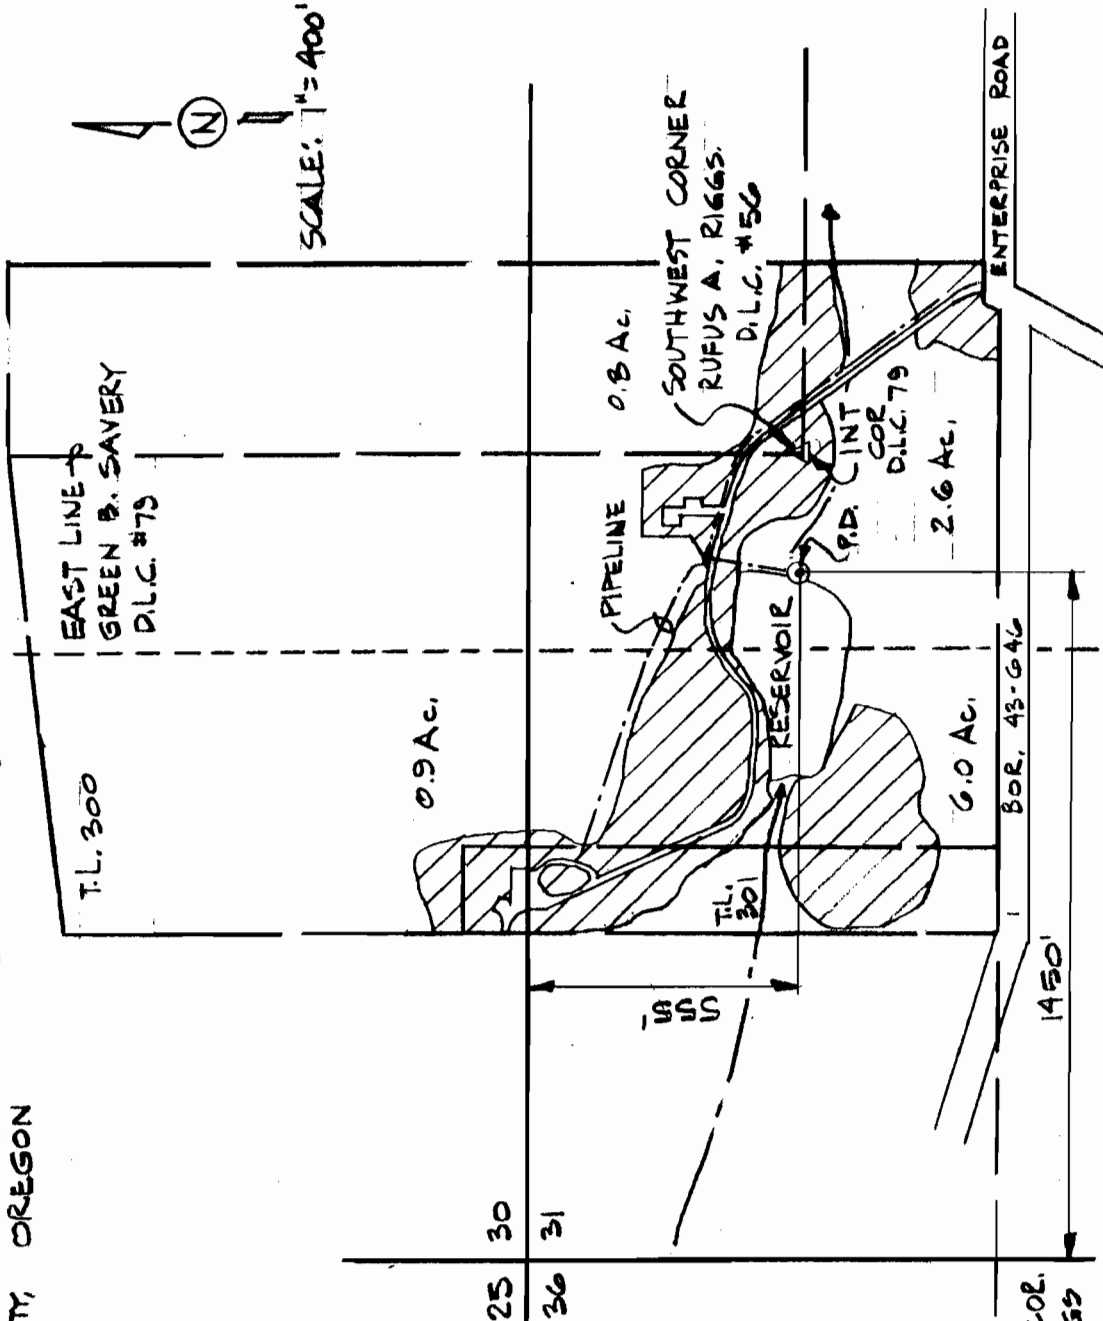


FINAL PROOF SURVEY

SURVEYED: SEPT. 20, 1993

APPLICATION NO.'S R-69893 & 69894 - PERMIT NO.'S R-11153 & 50725

PREPARATION OF THIS MAP IS FOR THE PURPOSE OF IDENTIFYING THE LOCATION OF THE WATER RIGHT ONLY. THERE IS NO INTENT TO PROVIDE DIMENSIONS OR LOCATION OF PROPERTY OWNERSHIP LINES.

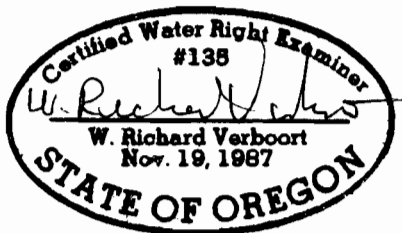

VERBOORT ENGINEERING
AGRICULTURE · CIVIL · WATER RESOURCES
HILLSBORO, OREGON

by date
designed WRV 9.93
drawn JER 9.93
checked WRV 9.93
drawing no. 93-A-15
sheet no. 1/1

BETSY B. MESSER
5515 ENTERPRISE ROAD
DALLAS, O.R. 97338