


SECTION 30 & 31, T.6S., R.5W., W.M.
POLK COUNTY, OREGON



VERBOORT ENGINEERING
AGRICULTURE · CIVIL · WATER RESOURCES
HILLSBORO, OREGON

designed	WRV 9-93	by	date
drawn	JER 9-93		
checked	WRV 9-93		
drawing no.	93-A-15		
sheet no.	1/1		

BETSY B. MESSER
5515 ENTERPRISE ROAD
DALLAS, OR. 97338

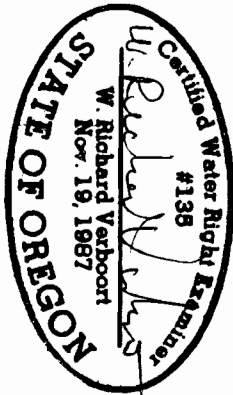

PREPARATION OF THIS MAP IS FOR THE PURPOSE OF IDENTIFYING THE LOCATION OF THE WATER RIGHT ONLY. THERE IS NO INTENT TO PROVIDE DIMENSIONS OR LOCATION OF PROPERTY OWNERSHIP LINES.

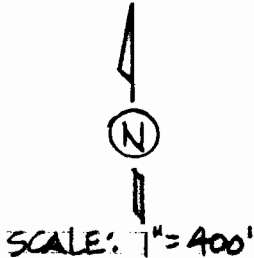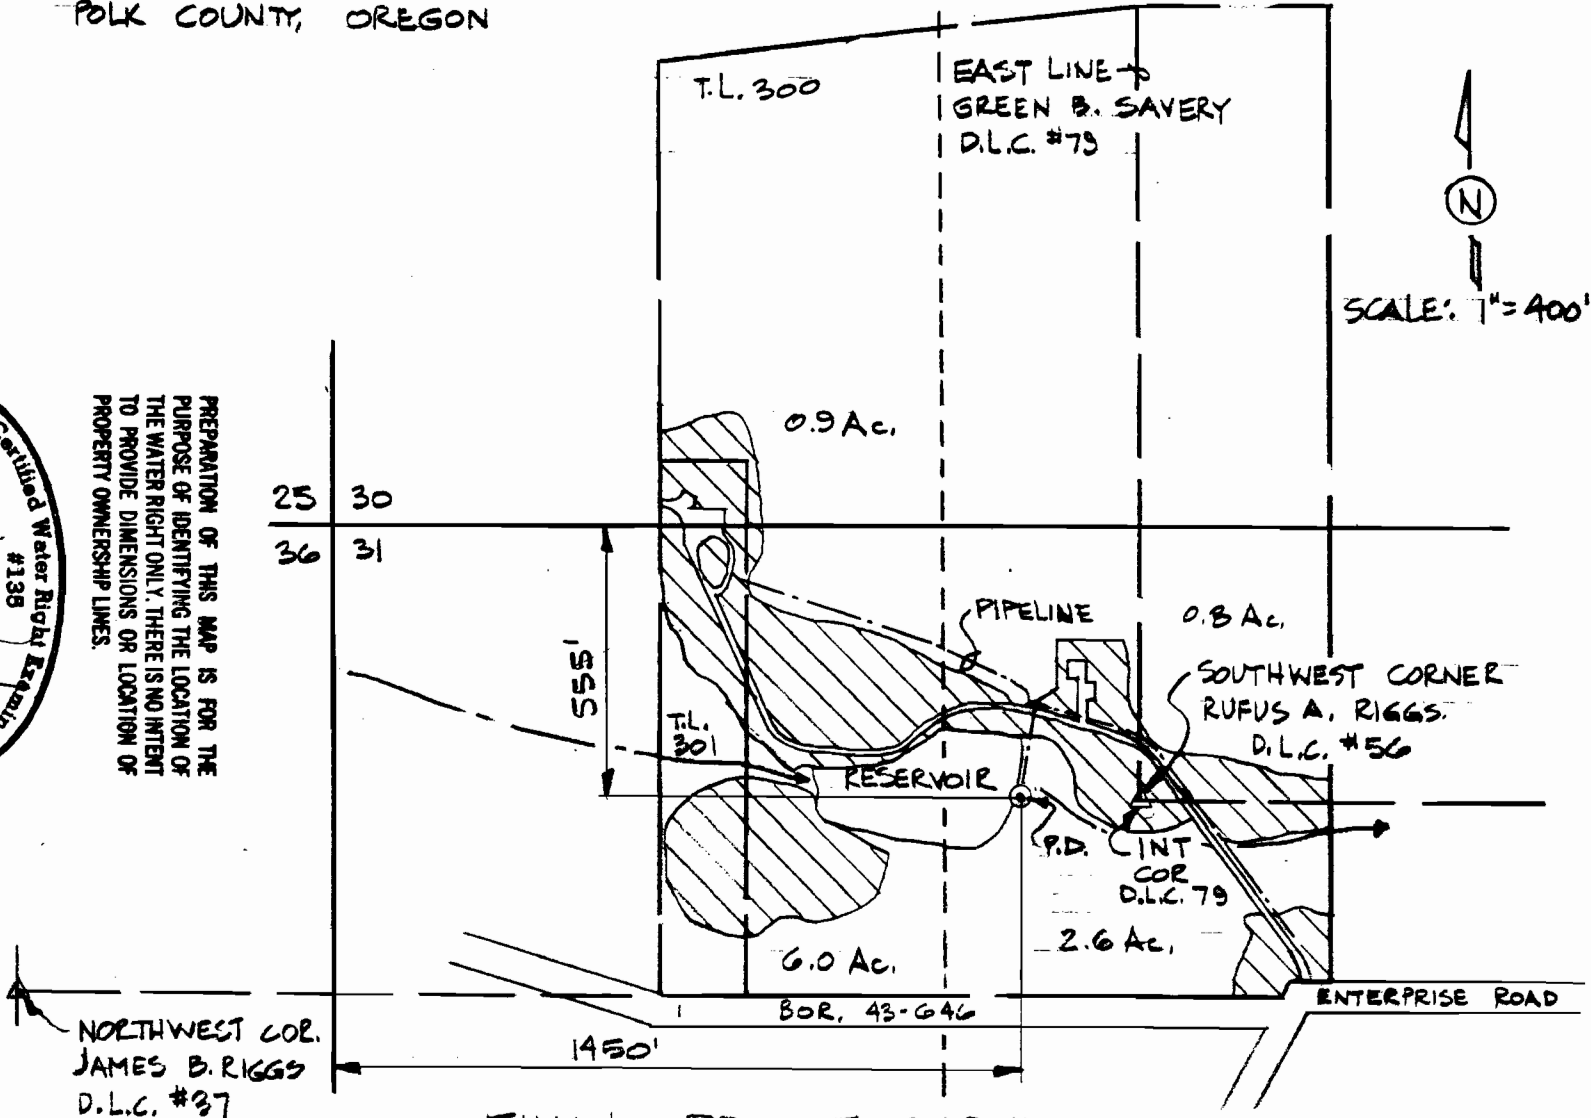

FINAL PROOF SURVEY

SURVEYED: SEPT. 20, 1993
APPLICATION NO.'S R-69893 & 69894 - PERMIT NO.'S R-11153 & 50725