


SECTION 30 & 31, T.6S., R.5W., W.M.
POLK COUNTY, OREGON


VERBOORT ENGINEERING
AGRICULTURE-CIVIL-WATER RESOURCES
HILLSBORO, OREGON

By date
designed WKV 9-23
drawn JER 9-23
checked WRV 9-23
drawing no. 93-A-15
sheet no. 1/1

BETSY B. MESSER
5515 ENTERPRISE ROAD
DALLAS, OR. 97338

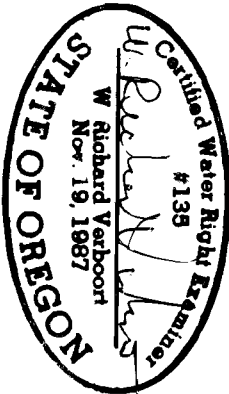

PREPARATION OF THIS MAP IS FOR THE
PURPOSE OF IDENTIFYING THE LOCATION OF
THE WATER RIGHT ONLY. THERE IS NO INTENT
TO PROVIDE DIMENSIONS OR LOCATION OF
PROPERTY OWNERSHIP LINES.

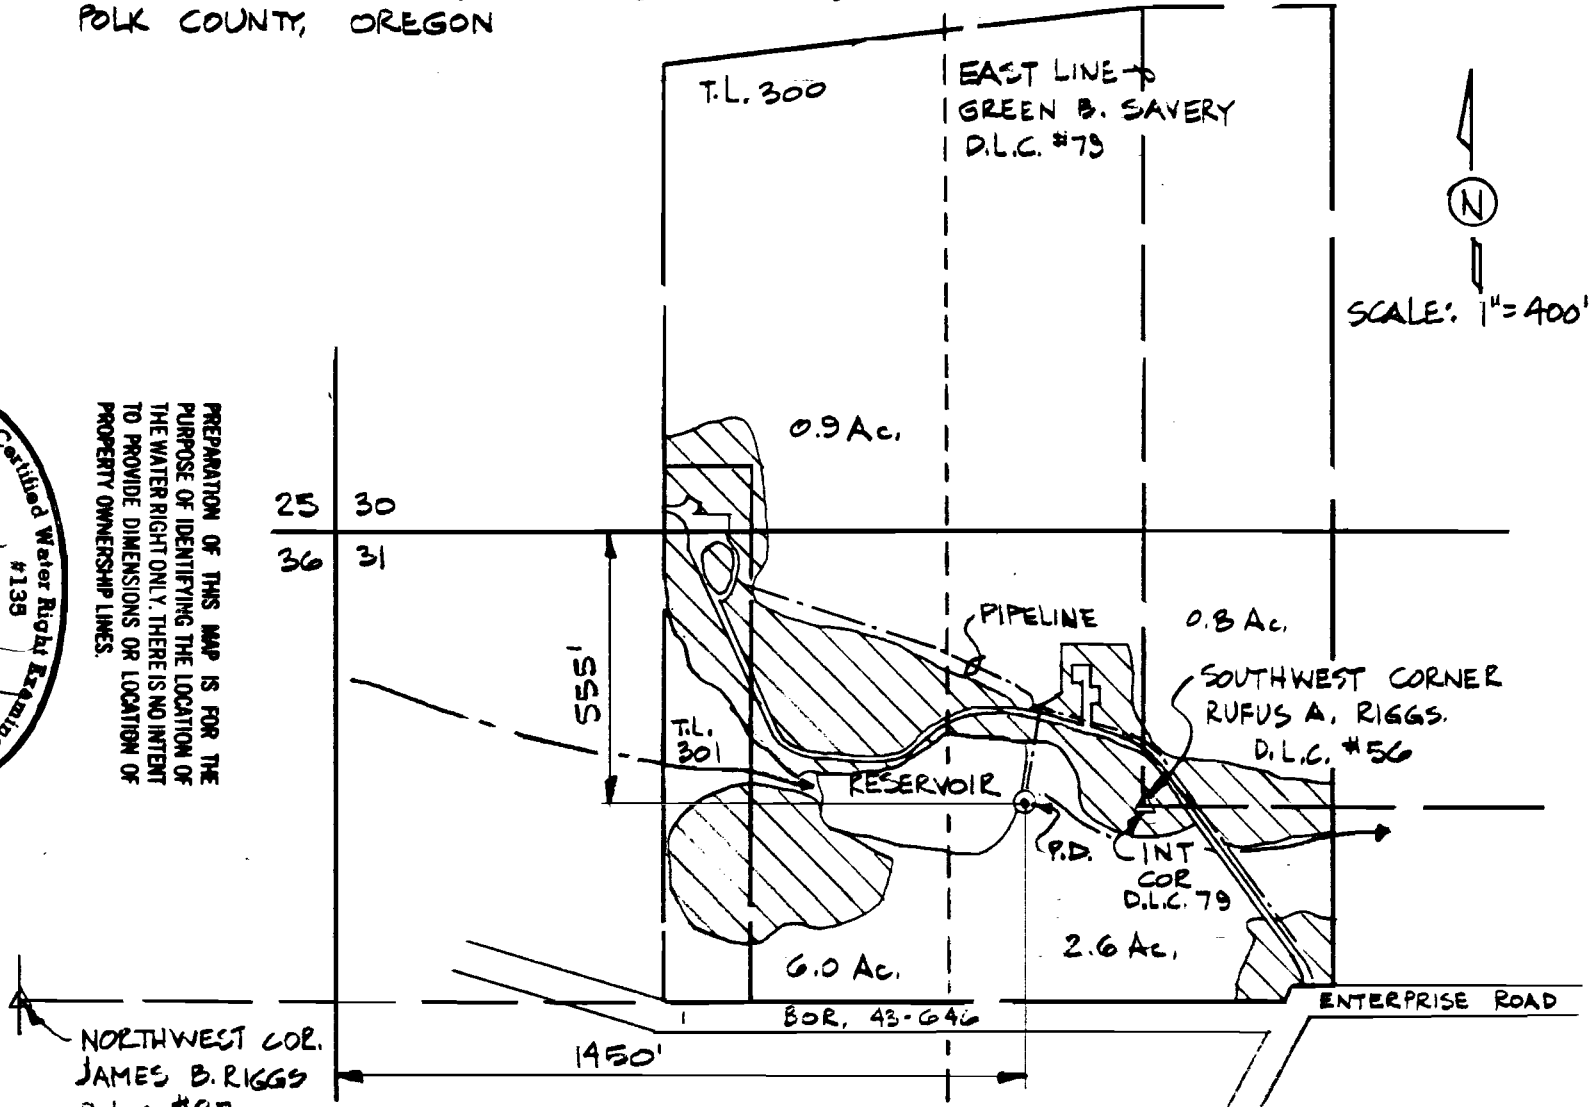

N
SCALE: 1" = 400'

FINAL PROOF SURVEY
SURVEYED: SEPT. 20, 1993
APPLICATION NO.'S R-69893 & 69894 - PERMIT NO.'S R-11153 & 50725