



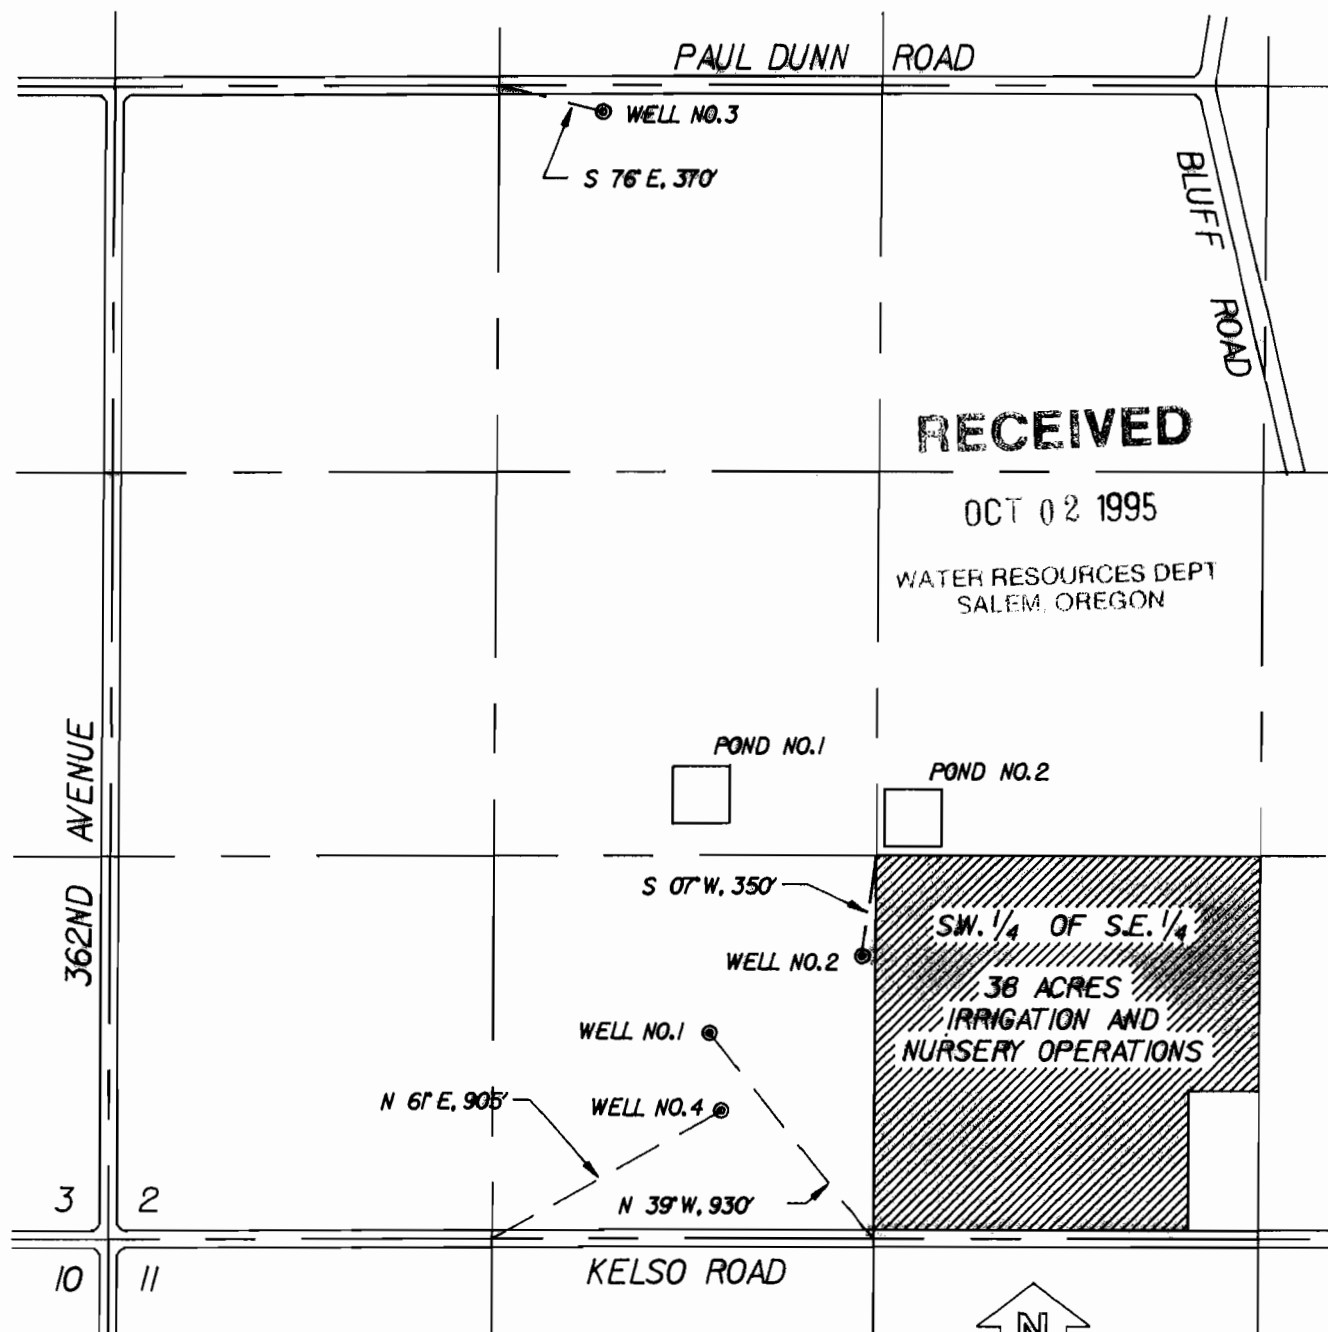

This drawing is an exhibit for a Final Proof Survey. It is not a Land Survey. Property lines and/or other lines of occupation shown hereon are not represented by the undersigned to meet accuracy standards of Land Surveys.

SCALE: 1" = 660'

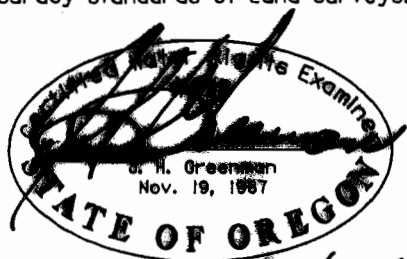


05/09/89

SECTION 2
T.22., R.4E., W.1.
CLATSOP COUNTY, OREGON

Application No. G-12356

Permit No. G-11216

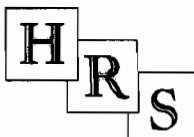

**HANER, ROSS &
SPORSEEN, INC.**

15 S.E. 82ND DRIVE
GLADSTONE, OREGON 97027

CHATELAIN'S NURSERY, INC.
FINAL PROOF SURVEY

6/4N