


RECEIVED

OCT 18 1993

PLAT RESOLUTION

PLAT NO. 1

T. 35 S., R. 3 W., W. M.

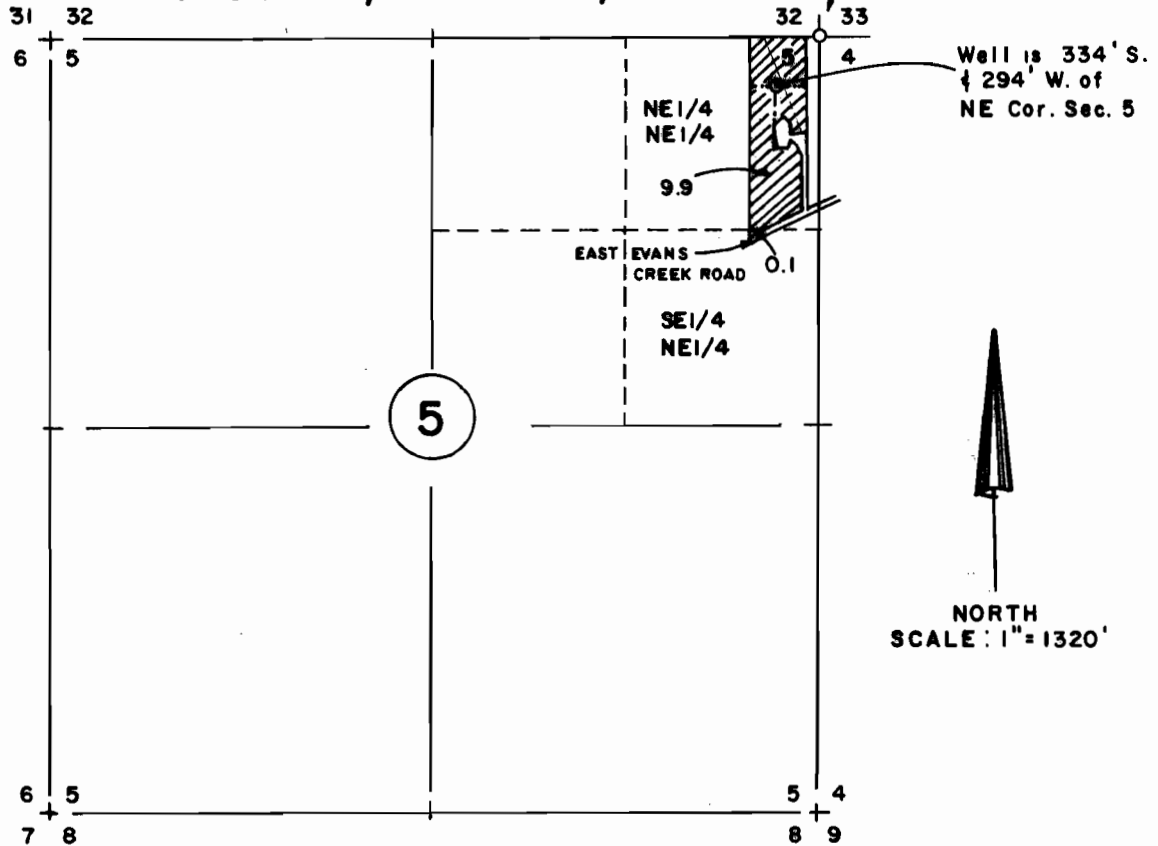

NOTE: THIS MAP HAS BEEN PREPARED FOR WATER RIGHT PURPOSES ONLY, NOT FOR PROPERTY BOUNDARY LOCATIONS

--- 400' ± of 1 1/4" PIPE

FINAL PROOF MAP

APPLICATION No. G-11980 PERMIT No. G-11217

IN THE NAME OF
ARTHUR J. & RUTH WORTH

