

T. 3 S., R. 4 W., W.M.



Located in the
SW1/4 SE1/4, SE1/4 SW1/4,
Section 30, T. 3 S., R. 4 W., WM,
Yamhill County, OR

Yamhill Co. tax lot 3430-1000

F. V. 172 P. 1715

U.S. Lot 3

I certify that the information I have provided
in this application is an accurate
representation of the proposed water use and is
true and correct to the best of my knowledge.
It is to be used for the purpose of identifying
the location of water right only and is not
intended to provide legal dimensions or
locations of property ownership lines.

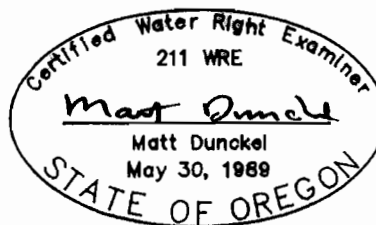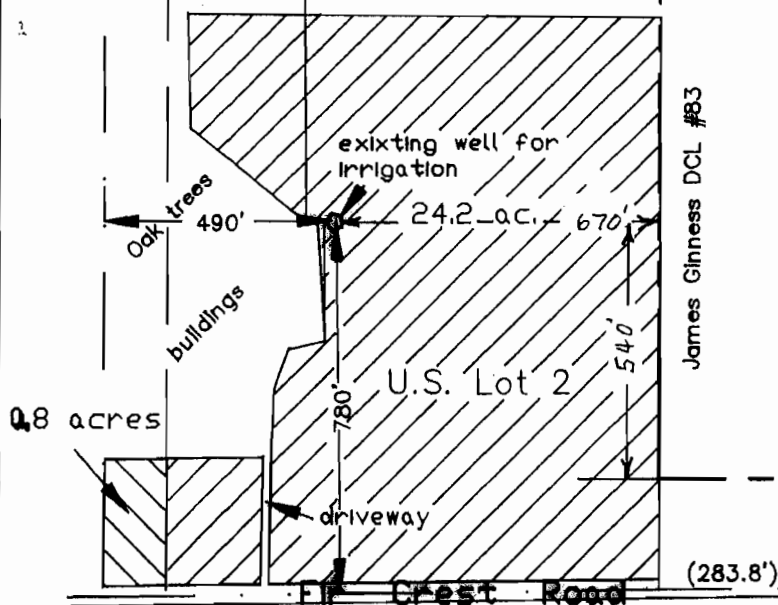

By: Matt Dunckel & Assoc.
19010 Baker Creek Road
McMinnville, OR 97128
Phone: 472-7904

30 29

31 32

FINAL PROOF SURVEY
UNDER

Application No. G-12322 Permit No. G-11260

IN NAME OF

ALVIN D. & CAROL A. ROY

RECEIVED

SEP 29 1993

WATER RESOURCES DEPT
SALEM, OREGON

North

Scale: 1" = 400'

Surveyed Sept. 17, 1993

794

AMENDED WRD 1/25/08 LHN