


FINAL PROOF MAP
SECTION 10 T37S R29E WM
HARNEY COUNTY OREGON
APPLICATION NO 69267
PERMIT NO 50751
GILLETT MC RANCH
(MC GROUP)

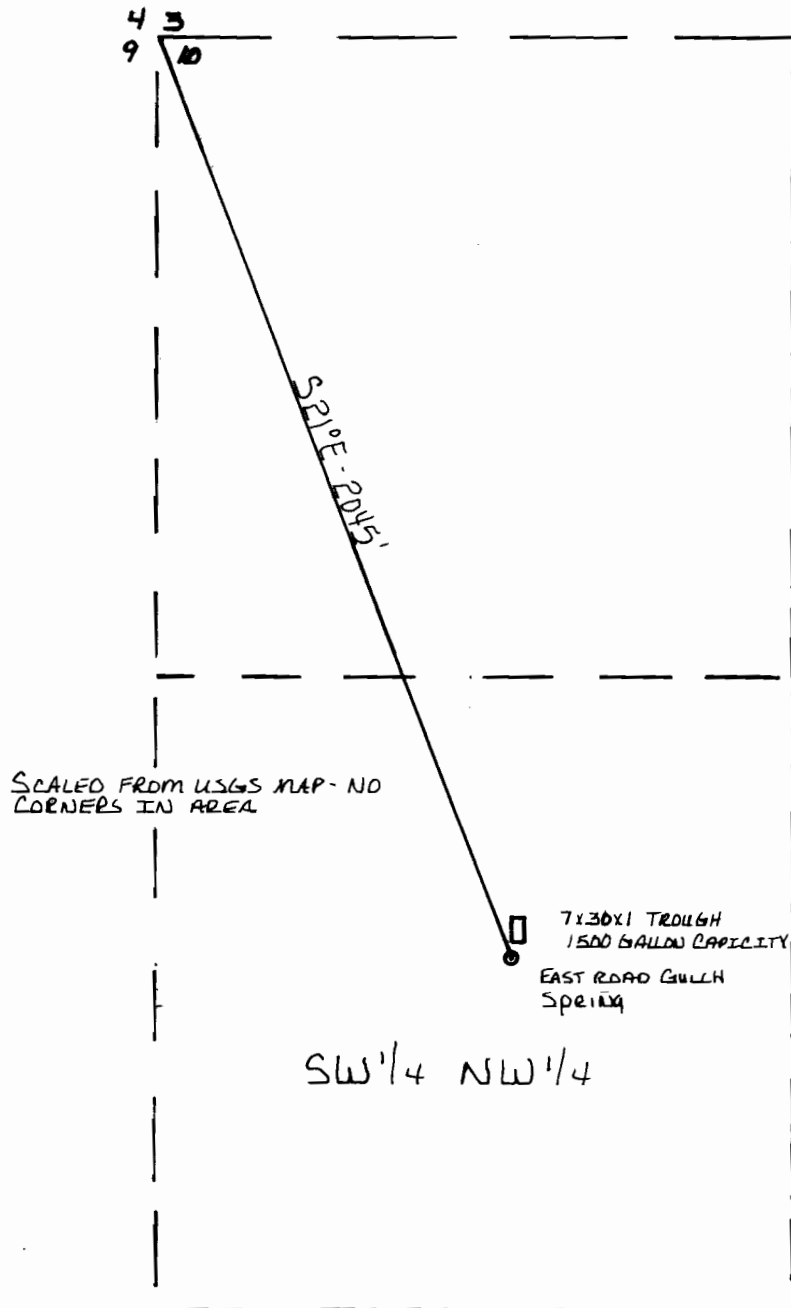

1" = 400'



This map is for the purpose of identifying the location of the water right only and is not intended to provide legal dimensions or location of property ownership lines.

DR*WR 5493

9-29-93

RETURN

6-11-94
HARNEY COUNTY
OREGON

RECEIVED

6-11-94
NATURAL RESOURCES DEPT
STATE OF OREGON



EXPIRES 12-31-94

REV 7-25-95