


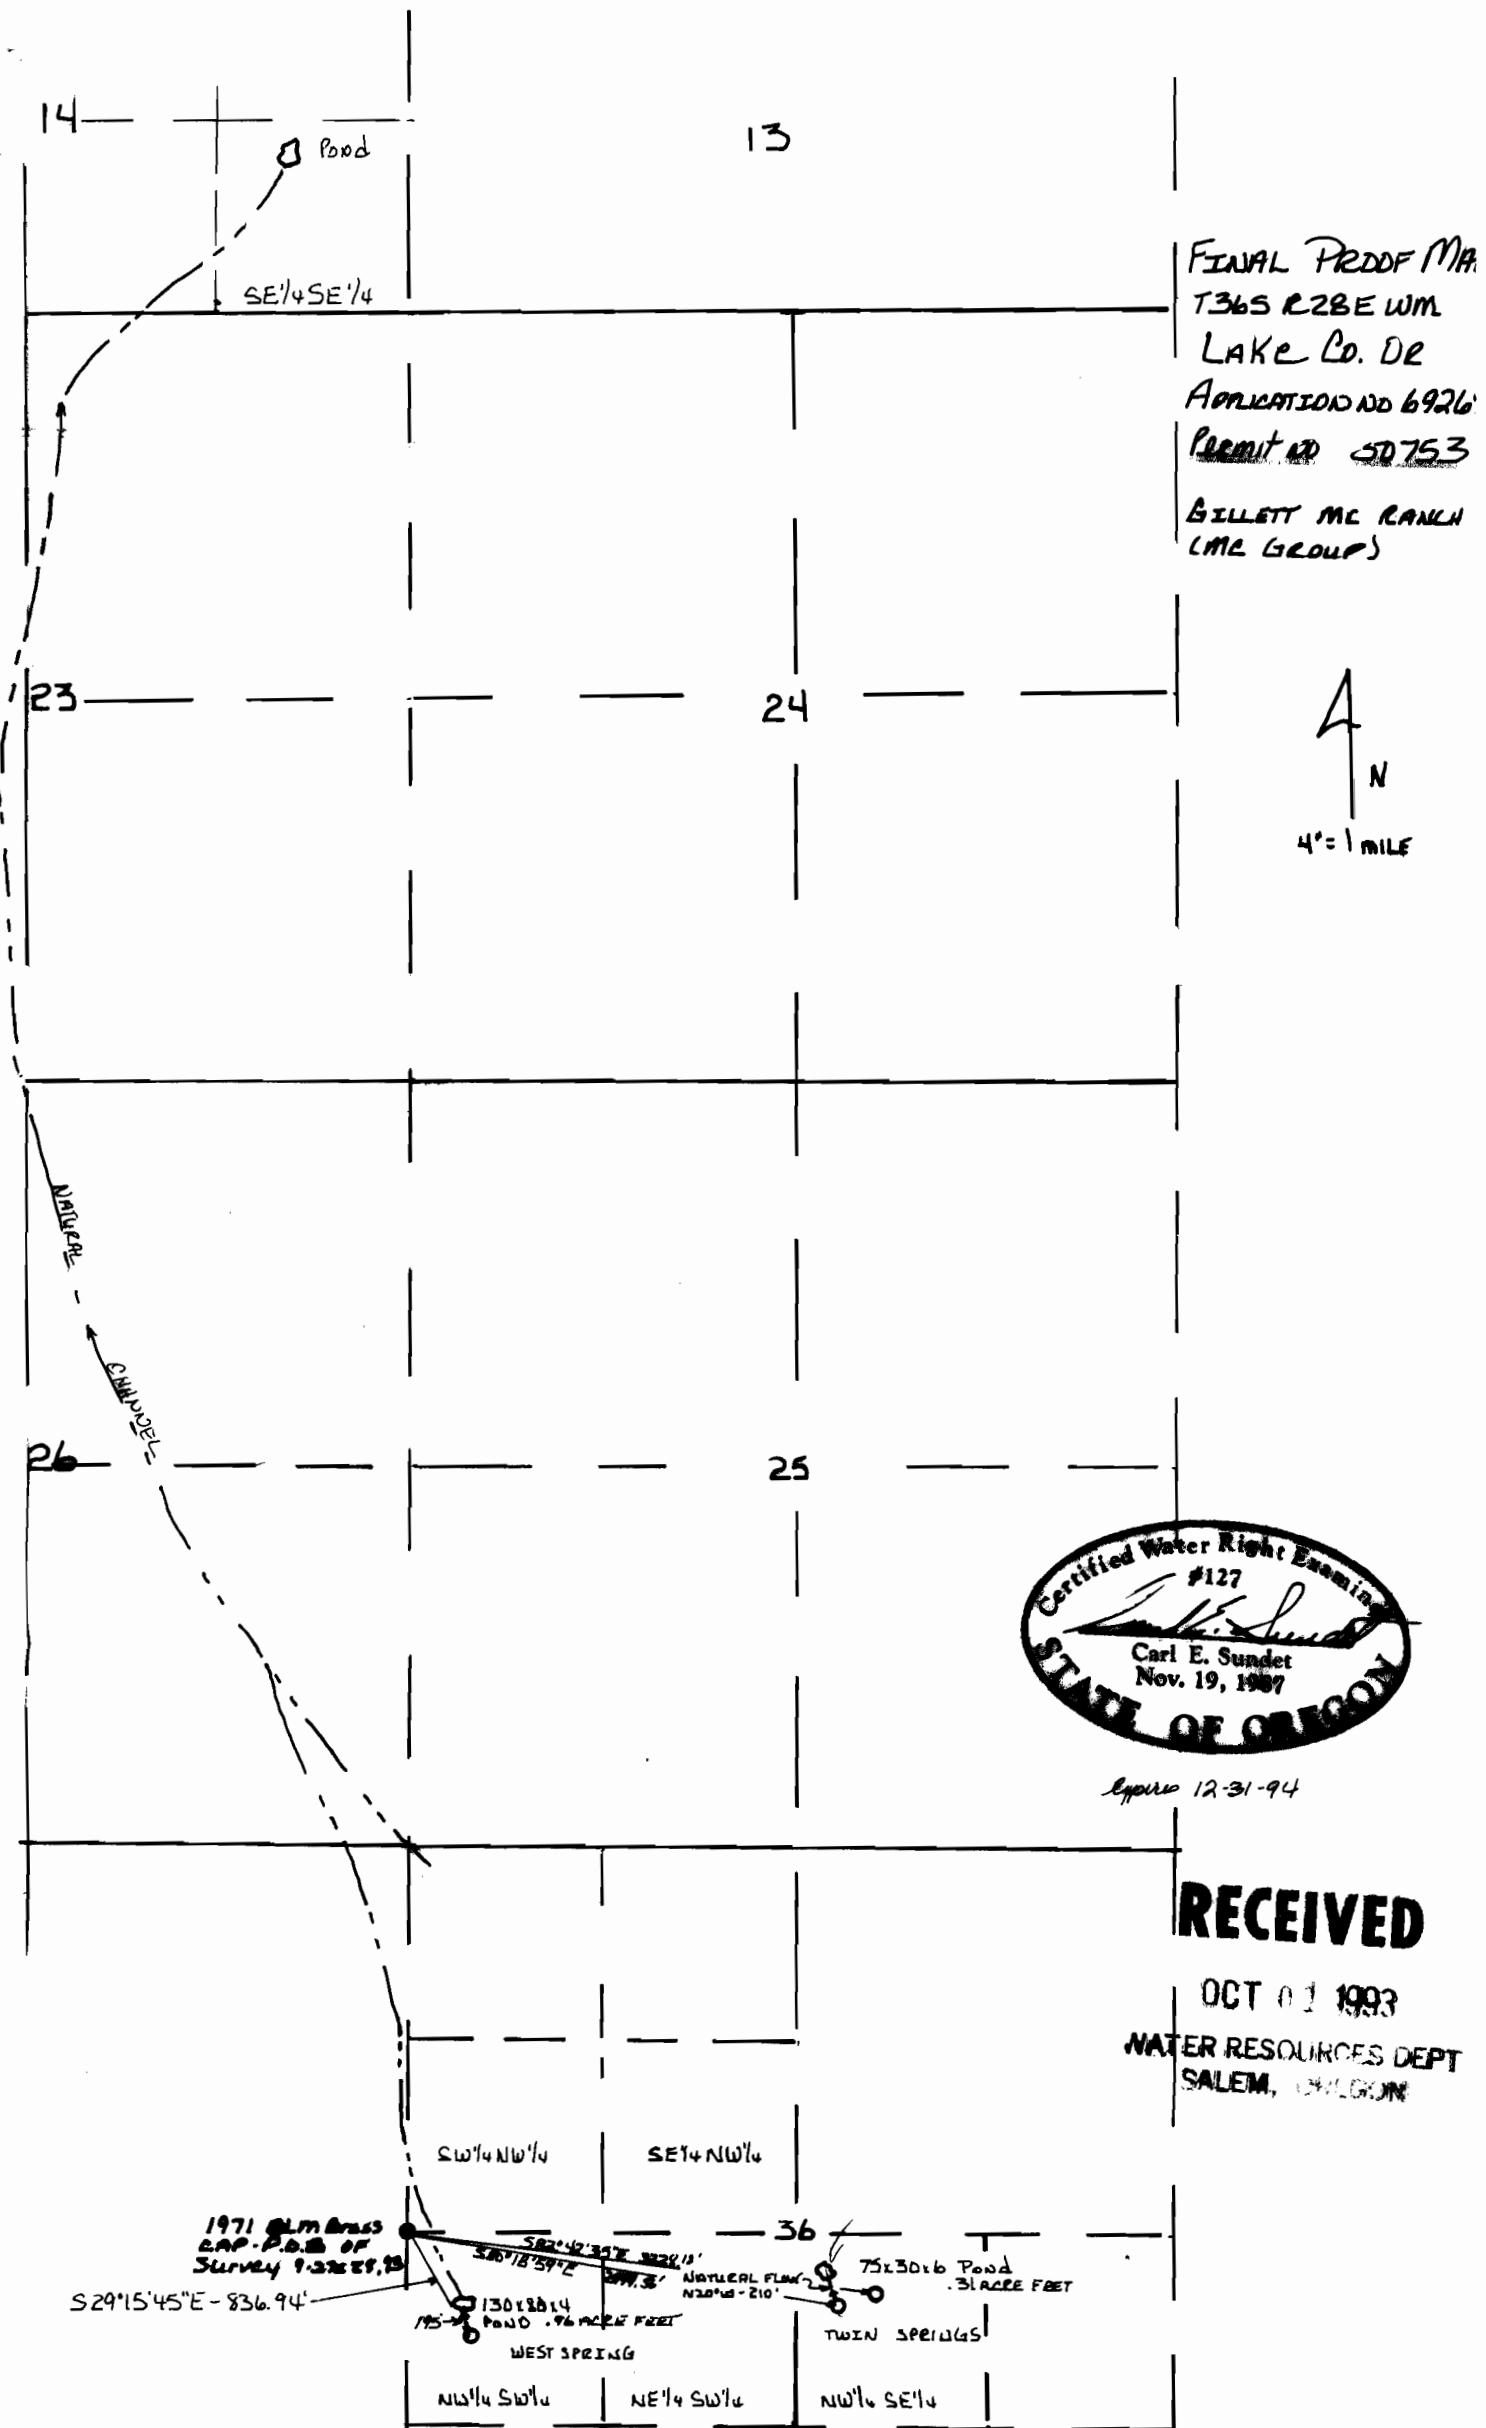

This map is for the purpose of identifying the location of the water right only and is not intended to provide legal dimensions or location of property ownership lines.