
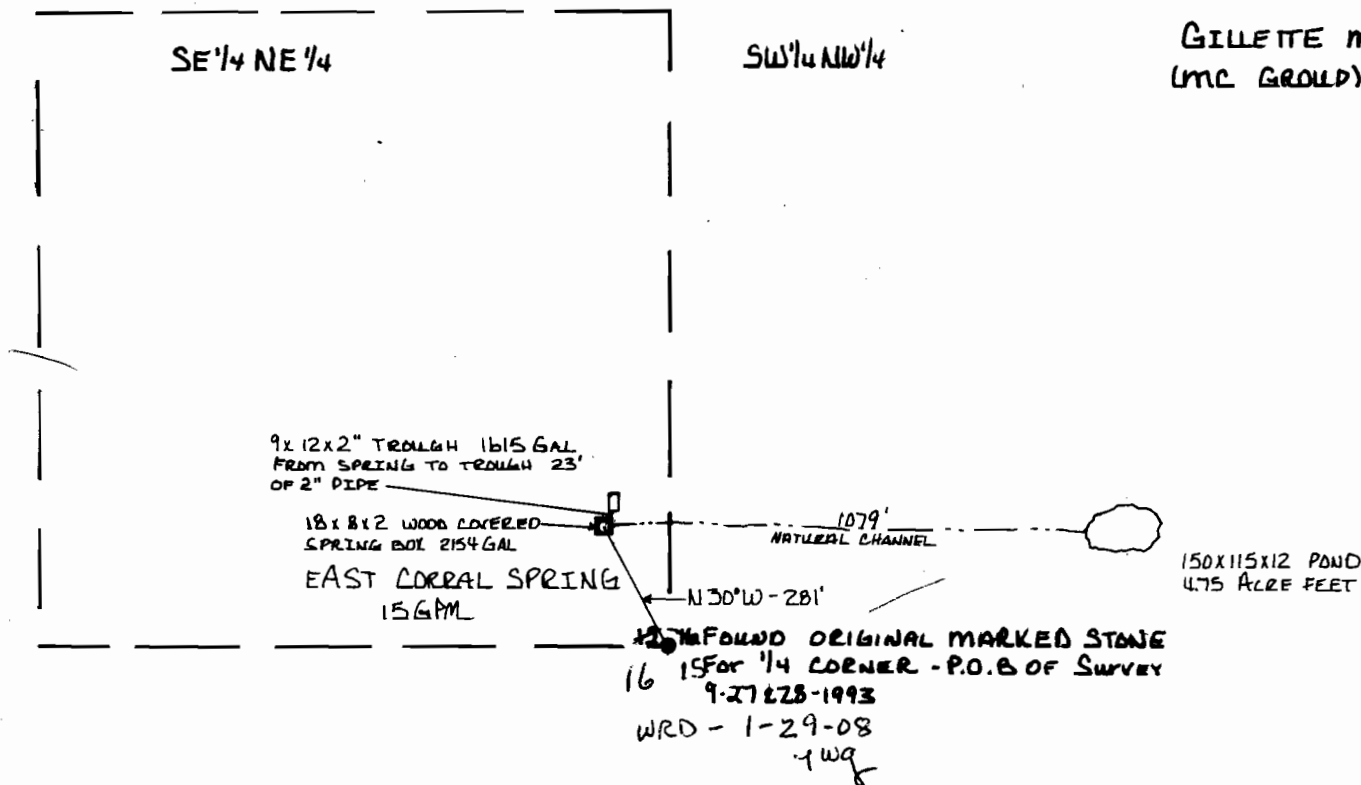


FINAL PROOF MAP

SECTION 16 T.37S R.29E. W.M.
HARNEY COUNTY, OREGON
APPLICATION NO 69270
PERMIT NO 50754
GILLETTE MC RANCH
(MC GROUP)

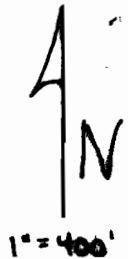

RECEIVED

WATER RESOURCES DEPT.
SALEM, OREGON

This map is for the purpose of identifying the location of the water right only and is not intended to provide legal dimensions or location of property ownership lines
DR # WR 5193 9-29-93



EXPIRES 12-31-94