


FINAL PROOF MAP

SECTIONS 20 & 29 T36S R29E W.M.
HARNEY COUNTY OREGON
APPLICATION NO 69271
PERMIT NO 50755
GILLET MC RANCH
(MC GROUP)

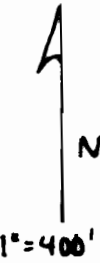

SW 1/4 SE 1/4 S. 20

11017016 POND 1.06 ACRE FEET

1/4 CORNER

S28°E
460'

EXISTING CREEK CHANNEL

DL SPRING
25 GPM


NW 1/4 NE 1/4 S. 29

This map is for the purpose of identifying the location of the water right only and is not intended to provide legal dimensions or location of property ownership lines.

DRAWING # WR 5293 9-29-93

RECEIVED

WATER RESOURCES DEPT
STATE OF OREGON

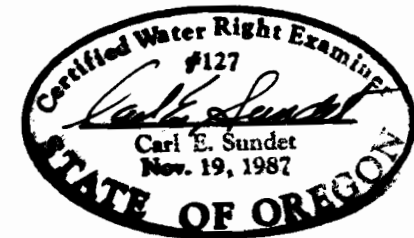

EXPIRES 12-31-94