


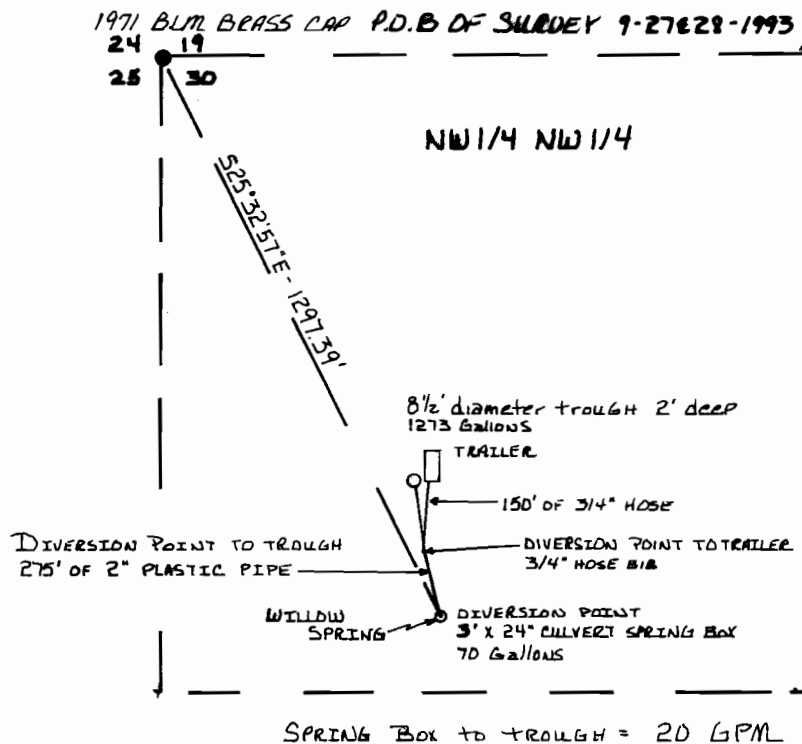

FINAL PROOF MAP

SECTION 30 T.36S. R.29E. W.M.

HARNEY COUNTY, OREGON

APPLICATION NO. 69272

PERMIT NO. 50756

GILLET MC RANCH

(MC GROUP)



1" = 400'

RECEIVED

WATER RESOURCES DEPT.
SALEM, OREGON



This map is for the purpose of identifying the location of the water right only and is not intended to provide legal dimensions or location of property ownership lines.

DRAWING # WRS 5093 9-29-93

EXPIRES 12-31-94