

● **Authorized POA**

Groundwater well in surface gravel aquifer (Well Log UMAT 4281) located in NW/4, NW/4 of Section 19 at a location 70 feet S and 97 ft E from NW Corner of Section 19.

----- **Conveyance**


4-inch mainline feeding 3-inch diameter aluminum handline. Water applied with WeatherTec 10-30 brass impact sprinklers with 5/32-inch nozzles.



Place of Use

7.4 acres, including:
4.6 acres in SW/SW Sec 18
2.8 acres in NW/NW Sec 19

The purpose of this map is to identify the location of a water right. It is not intended to provide information regarding the location of property ownership boundary lines.

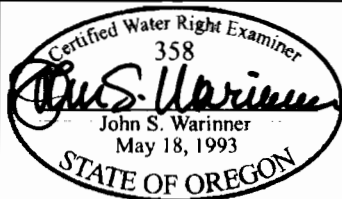

FOUNTAINHEAD
1860 Blue Creek Road
Walla Walla, WA 99362
509.529.2646 phone

**COBU MAP
Transfer 9830**

in the name of
**KURT & ERICKA
HELLBERG**

Revised 15 JAN 2008