


**T10S, R10W, W.M.
SECTION 33
LINCOLN COUNTY, OREGON**

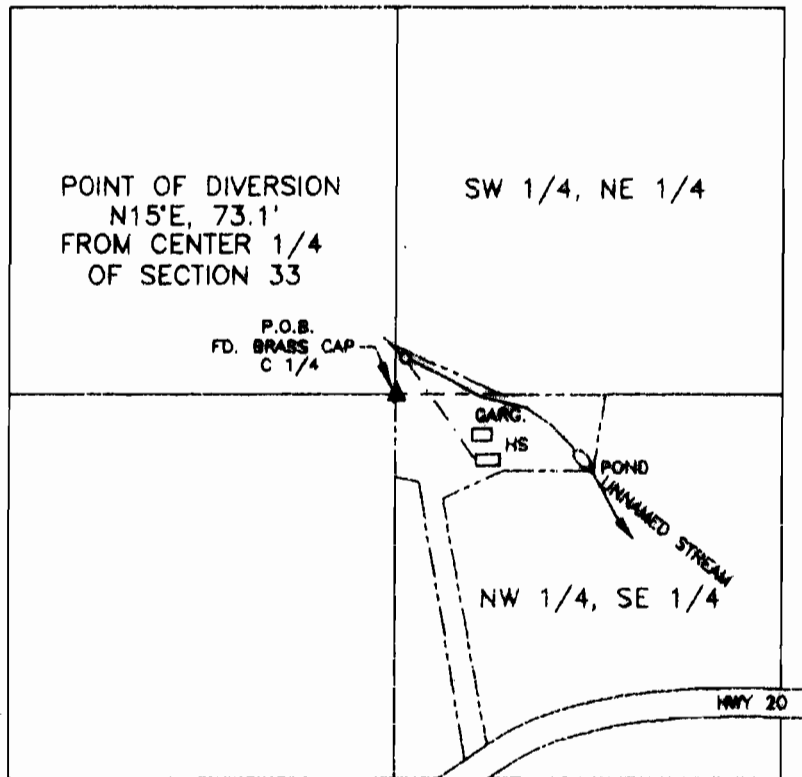


SCALE: 1" = 400'

**CLAIM OF BENEFICIAL USE MAP
FOR**

WILLIAM T. MONTGOMERY

LESS THAN 1/2 ACRE

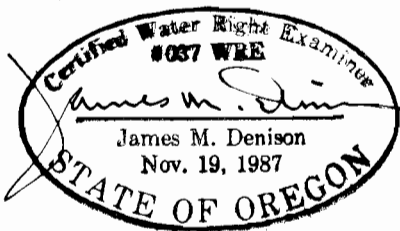

APPLICATION # 70362

PERMIT # 51353

**IN THE NAME OF
WILLIAM T. MONTGOMERY**

SURVEYED JULY 28, 1994

BY: J.M. DENISON

THIS MAP PREPARED SOLEY FOR THE PURPOSE OF SHOWING LOCATION OF A WATER RIGHT, AND IS NOT INTENDED FOR USE TO PROVIDE DIMENSIONS OR LOCATION OF PROPERTY OWNERSHIP LINES