


TOWNSHIP 16 SOUTH, RANGE 4 WEST, W.M.

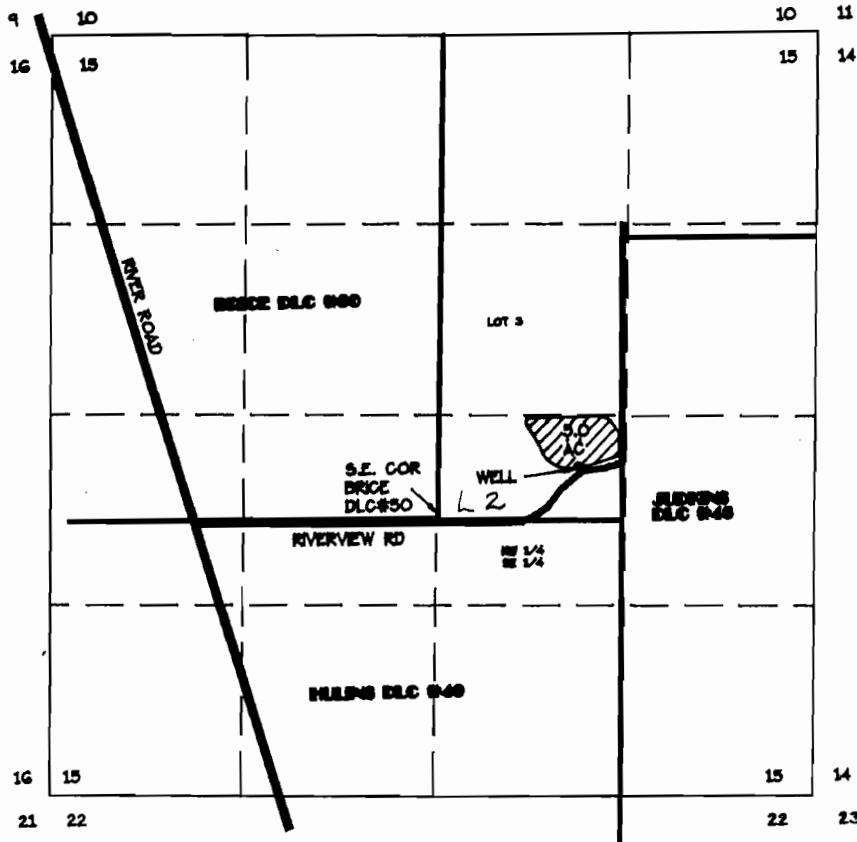

SCALE 1" = 1000'


APP. #G12083 PERMIT #G11560

WELL LOCATION:

315.92 FEET NORTH + 999.23 FEET
EAST OF THE S.E. CORNER OF THE
BRICE DLC #50.



AREA OF FINAL PROOF

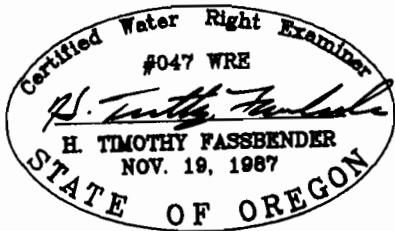

FINAL PROOF SURVEY
FOR
AUDREY FARVER
82891 RIVER ROAD
JUNCTION CITY, OREGON 97448
PH (503) 888-6465

BY
FORD - NESS - FASSBENDER
1120 BAILEY HILL RD #1
EUGENE, OREGON 97402
PH (503) 344-1882
NOVEMBER 15, 1984

NOTE:
THIS MAP WAS PREPARED FOR THE PURPOSE
OF IDENTIFYING THE LOCATION OF THE
WATER RIGHT ONLY. IT IS NOT INTENDED TO
PROVIDE DIMENSIONS OR LOCATION OF
PROPERTY OWNERSHIP LINES.

JOB NO. 1052.03