
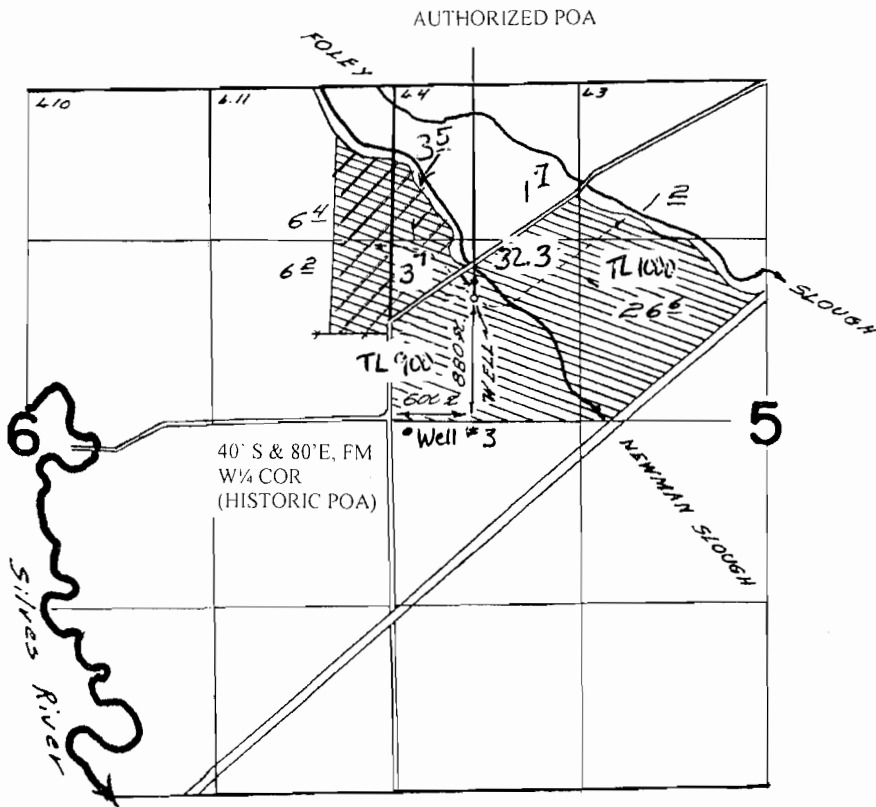


APPLICATION MAP FOR LOUIS MOLT
 ADDITIONAL P.O.A TO REFLECT
 HISTORIC USE T-10362

AMENDED 3/13/08

T. 23 S. R. 31 E. W. M.

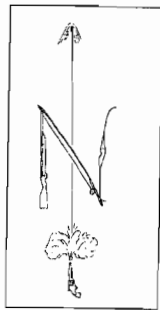

SCALE 1"=1320'



LANDS UNDER HISTORIC POA TRANSFER
 CERTIFICATE 35134



REMAINING RIGHTS
 CERTIFICATE 35134