


BASE MAPPING BY MIKE McALLISTER ENGINEERING. THIS MAP HAS BEEN PREPARED FOR THE SOLE PURPOSE OF IDENTIFYING THE REQUESTED WATER RIGHT LOCATION. THERE IS NO INTENT BY EGR & ASSOCIATES, INC. TO VERIFY THE ACCURACY OF THIS MAP OR TO PROVIDE DIMENSIONS OR LOCATIONS OF PROPERTY OWNERSHIP LINES.

SE 1/4 OF SW 1/4  
17.27 AC.

SW 1/4 OF SW 1/4  
SEC. 23  
1.14 AC.

NW 1/4 OF NW 1/4 OF SEC. 26  
13.38 AC.

STORAGE RESERVOIRS;  
4-9,000 GAL TANKS  
SOUTH 1030', EAST 1020'  
OF NW COR., SEC. 26

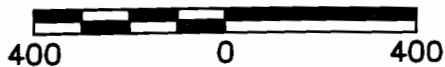


| AREA OF USE |     |     |
|-------------|-----|-----|
| SECTION     | 1/4 | 1/4 |
| 23          | SE  | SW  |
|             | SW  | SW  |
| 26          | NE  | NW  |
|             | NW  | NW  |
|             | NW  | NE  |

- SECTION LINE
- PROPERTY BOUNDARY
- - - BOUNDARY SILTCOOS LAKE
- (4" OR 3") SUPPLY LINE / SIZE
- (2") DISTRIBUTION LINE / SIZE
- SUBJECT SITE
- GOVERNMENT LOT

DISTRIBUTION PUMP STATION  
METER LOCATION

POINT OF DIVERSION;  
SUBMERSIBLE PUMP INTAKE  
AND LOCATION OF FISH SCREEN  
SOUTH 330', EAST 3,000 OF  
NW COR. SEC. 26

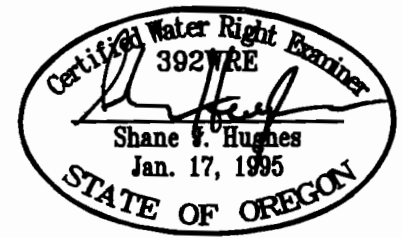

EXPIRATION DATE: 6/30/09

T19S., R12W., W.M.  
SECTIONS 23 AND 26  
WATER RIGHT TRANSFER APPLICATION, PERMIT # T-9398  
MAPS 19122334, 19122612, 19122621, AND 19122622  
LANE COUNTY, OREGON  
SEPTEMBER 25, 2006

RECEIVED  
APR 23 2008  
WATER RESOURCES DEPT  
SALEM, OREGON

**EGR & Associates, Inc.**  
Engineers, Geologists, and Surveyors

2535B Prairie Road  
Eugene, Oregon 97402

(541) 688-8322  
Fax (541) 688-8087