


T.35S.,R.1W.,W.M.  
Jackson County, Oregon  
Tax Lot No. 351W 17 - 257

**RECEIVED**  
SEP 19 2003  
WATER RESOURCES DEPT.  
SALEM, OREGON



SCALE 1" = 400'

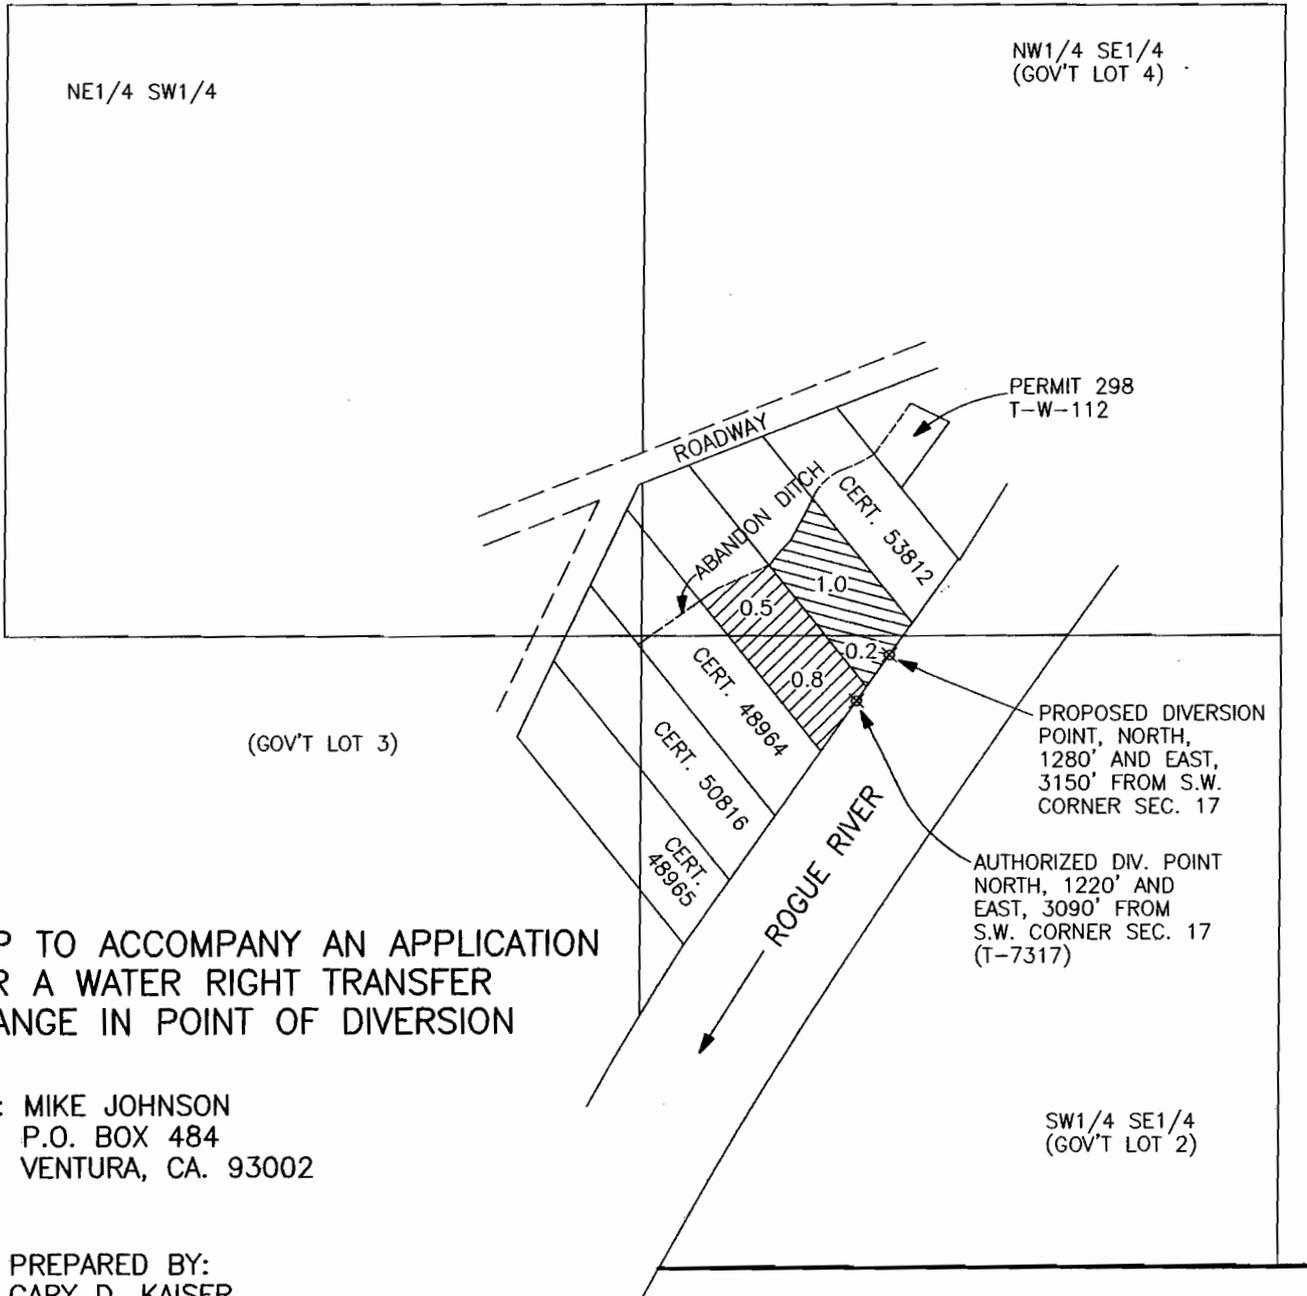

MAP TO ACCOMPANY AN APPLICATION  
FOR A WATER RIGHT TRANSFER  
CHANGE IN POINT OF DIVERSION

FOR: MIKE JOHNSON  
P.O. BOX 484  
VENTURA, CA. 93002

PREPARED BY:  
GARY D. KAISER  
KAISER SURVEYING  
19440 HWY. 62  
EAGLE POINT, OR. 97524

SEPTEMBER 2, 2003

NOTE: MAP PREPARED FOR  
WATER RIGHT PURPOSES ONLY,  
NOT FOR PROPERTY BOUNDARY  
LOCATIONS.

 = PORTION OF T-7317  
REQUESTING NEW DIVERSION POINT

 = PORTION OF T-7317  
NO CHANGE

T9552

