

T30S

R3W


SEC. 26

Scale 1" = 400'

| | |
|----|----|
| 23 | 24 |
| 26 | 25 |

RECEIVED
 NOV 16 1973
 STATE ENGINEER
 SALMON, OREGON

RECEIVED
 JUL 2 1971
 STATE ENGINEER
 SALMON, OREGON

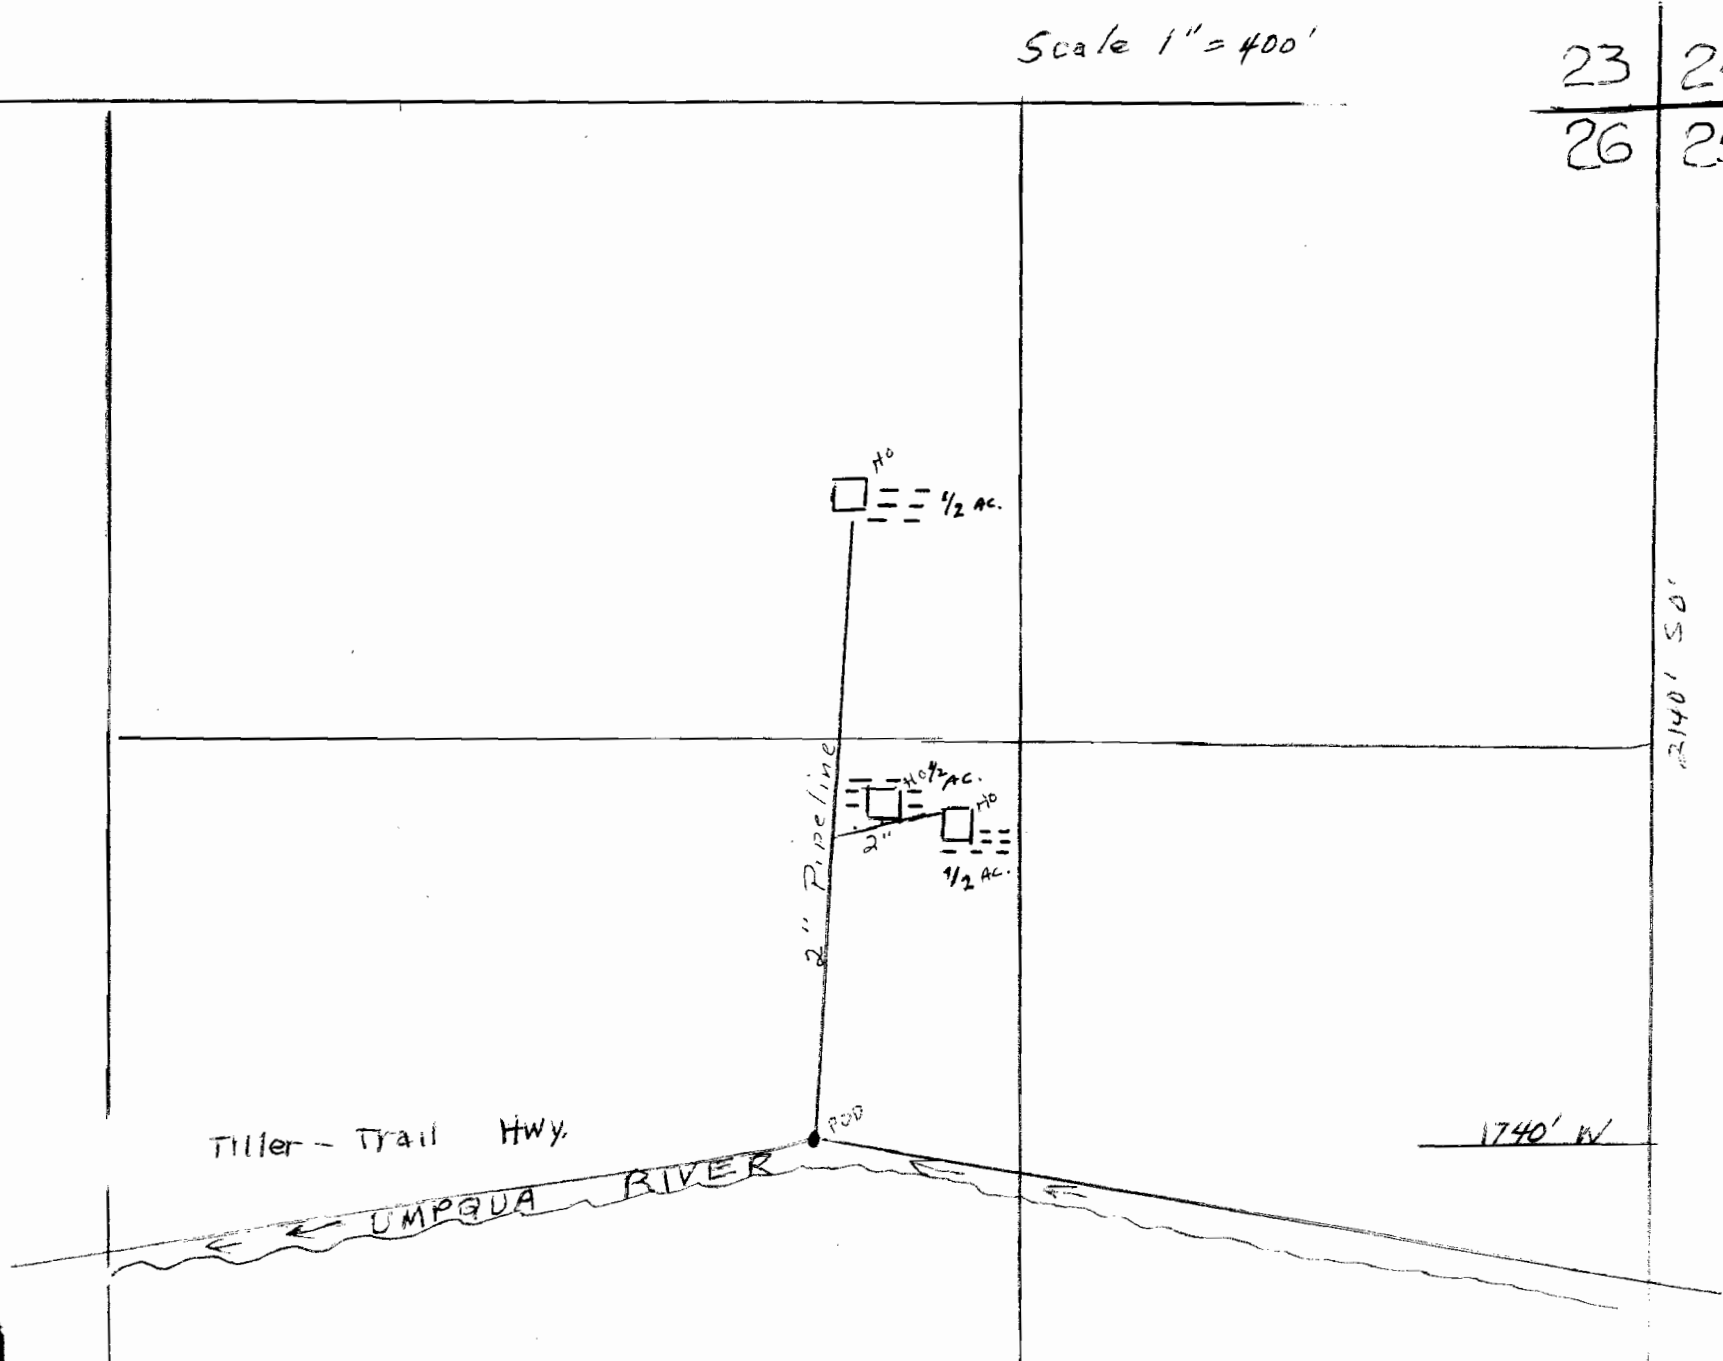

Application No. 50793

Permit No. 38353

← Stream Flow