


# T.4S. R.2W. W.M.

MARION COUNTY

A RHOADES

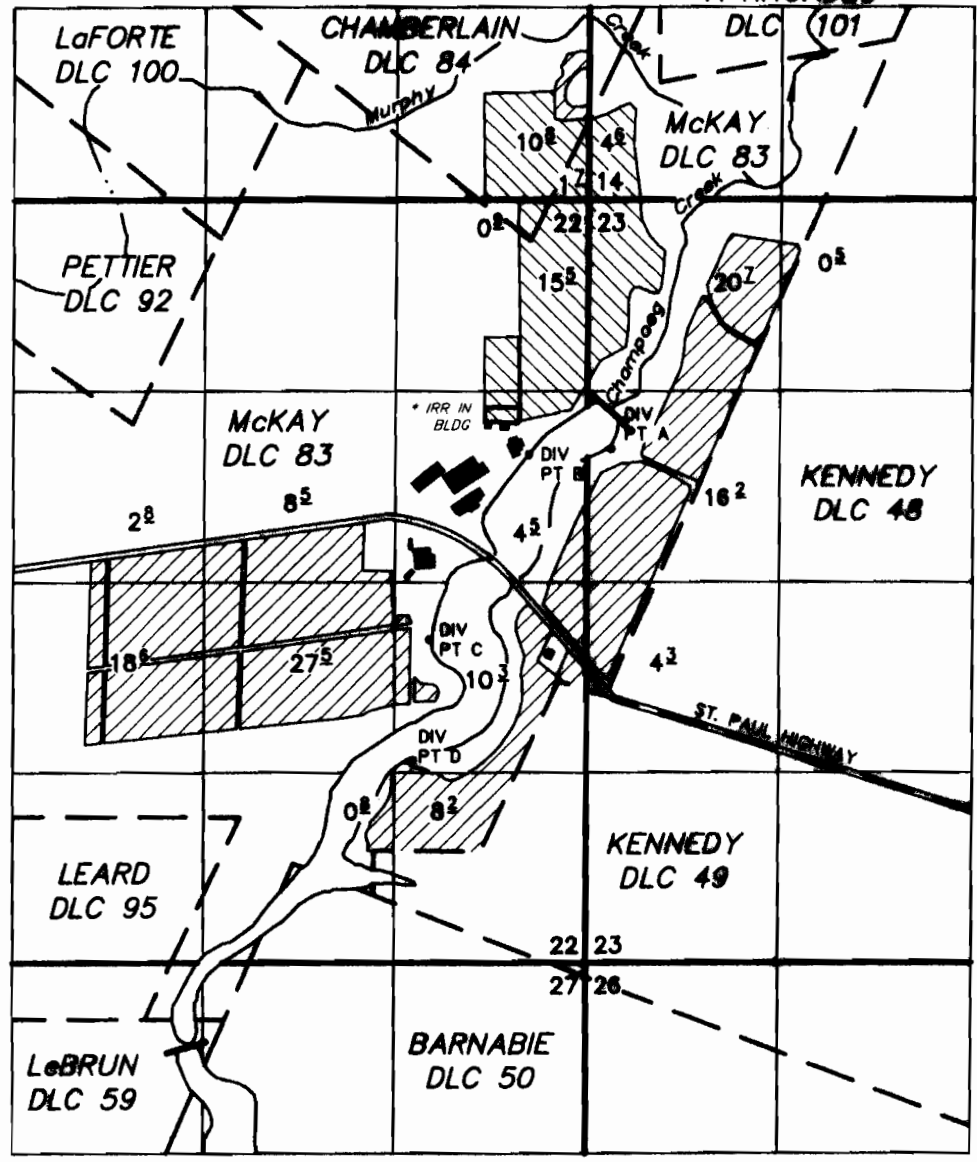

TAX LOTS:  
 042W22 00100  
 042W22 00201  
 042W22 00400  
 042W22 00500  
 042W23 00400

\* NOTE:  
 HARVESTED NURSERY  
 STOCK HELD IN BLDG  
 PRIOR TO SHIPMENT IS  
 IRRIGATED.

DIV PTS: 'A' 1670' N & 520' W, 'B' 1710' N & 60' E, 'C' 390' N & 1205' W,  
 AND 'D' 470' S & 1315' W OF THE SW COR KENNEDY DLC 48

## FINAL PROOF SURVEY

1/40 CFS  
 1/80 CFS

GR-2514	18870	GR-3833
23594	18870	22653
24254	19152	24622
26626	20850	24651
R-44070	R-4964	39930
44071	32366	39929
45166	33745	39931
S-72041	51961	

**RECEIVED**

WATER RESOURCES DEPT  
 SALEM, OREGON

Application No. \_\_\_\_\_ Permit No. \_\_\_\_\_ Certificate No. \_\_\_\_\_

### A & R SPADA FARMS AND ANGELO J. & JOAN T. SPADA

SEPTEMBER 14, 1999  
 rev DECEMBER 5, 2007  
 SCALE: 1" = 1320'



NOTE: This map is for the purpose of identifying the location of water rights and has no intent to dimension or locate property ownership lines.