


RECEIVED

JAN 28 2008

WATER RESOURCES DEPT  
SALEM, OREGON

T.4S. R.2W. W.M.  
MARION COUNTY

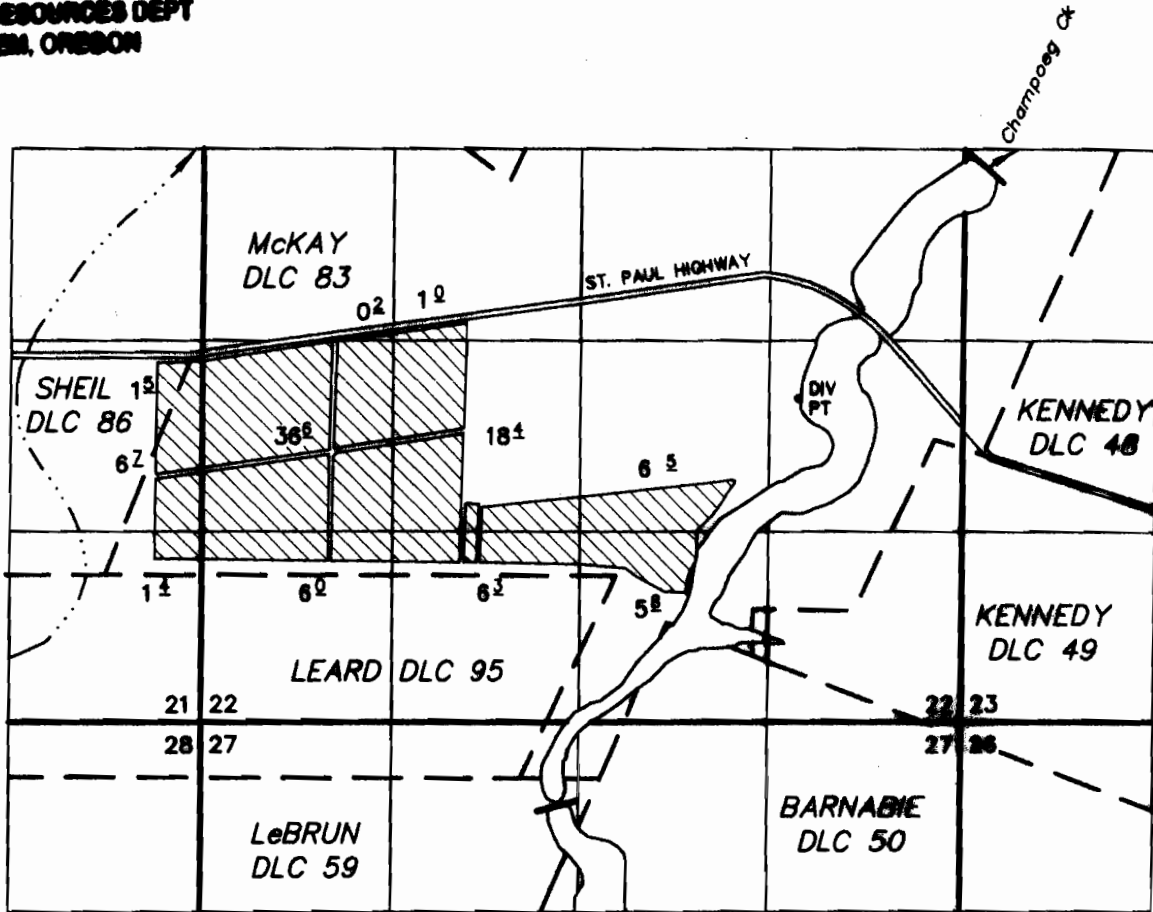

DIV PT: 390' N & 1205' W FROM SW COR KENNEDY DLC 48

TAX LOTS:  
042W22 00300  
042W22 00400

# FINAL PROOF SURVEY

UNDER

GR-3298 ON A PORTION OF THIS LAND NO LONGER IN USE.

Application No. S-72043 Permit No. 51963

## A & R SPADA FARMS

SEPTEMBER 14, 1999  
rev DECEMBER 7, 2007  
SCALE: 1" = 1320'

NOTE: This map is for the purpose of identifying the location of water rights and has no intent to dimension or locate property ownership lines.

