

SECTION 12, T. 5 S., R. 5 W., W.M.

1 INCH = 400 FEET

RECEIVED

JUL - 7 1993

WATER RESOURCES DEPT.
SALEM, OREGON

NE 1/4 SE 1/4

River Bend

Road

NW 1/4 SE 1/4

SOUTH YAMHILL RIVER

Point of Diversion 2

SW Corner N 1/2
Monroe DLC 74
(C.S. 2431)
(Fd.)

Drain

Drain

Ditch

J. MONROE
DLC 74

Ditch

SE 1/4 SW 1/4

SW 1/4 SE 1/4


SE 1/4 SE 1/4

Ditch

West Line Monroe DLC 74

Point of Diversion 2 is
North 82 feet and West
31 feet from the South-
west corner of the North
One-half Monroe DLC 74

The purpose of this map is to
identify the location of the Water
Right. It is not intended to pro-
vide information relative to the
location of Property Ownership
Boundary Lines.

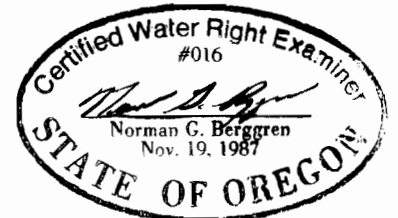

FINAL PROOF SURVEY
UNDER

IN THE NAME OF: STEVEN E. RICE

70675 + 70676

SURVEYED: June 4, 1993

BY: Norman G. Berggren

AMENDED WRP 2/4/88 LHN

