


T. 5 S., R. 4 W., W.M. **RECEIVED**


MAY 16 1997

Location: SE 1/4 & SW 1/4 of the NW 1/4
of Section 26, T.5 S., R.4 W.,
W.M., Yamhill County, Oregon.

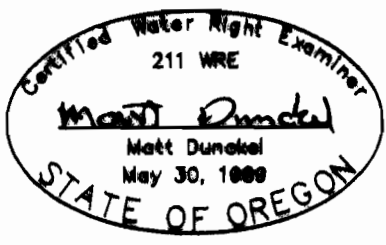

By: Matt Dunckel & Assoc.
19010 Baker Creek Road
McMinnville, OR 97128
Phone: 472-7904

- ① stone at the NE cor. FISHER, FV 160 P 1711 CS-1112
- ② steel fence post per CSP-8064 and angle in north line FISHER

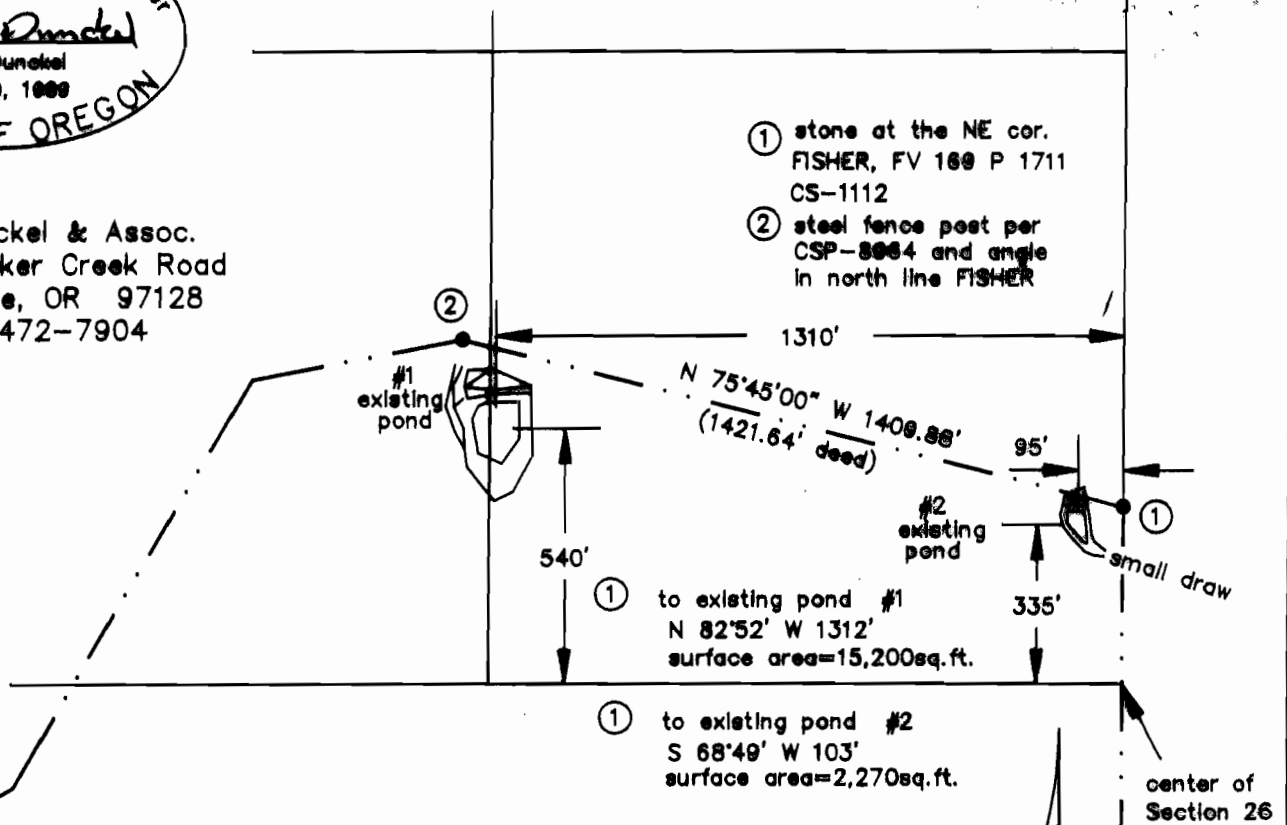

I certify that the information I have provided in this Final Proof is an accurate representation of the permitted water use and is true and correct to the best of my knowledge. This map is to be used for the purpose of identifying the location of water right only and is not intended to provide legal dimensions or locations of property ownership lines.

Matt Dunckel
Matt Dunckel, CWRE

Scale: 1" = 400'

FINAL PROOF SURVEY
UNDER

Application No. R-69456 Permit No. R-11265
IN NAME OF

DARYL A. FISHER

Surveyed Nov. 8, 1993

FIVE
NOV 09 1997

T. 5 S., R. 4 W., W.M. **RECEIVED**
 MAY 16 1997

Supplement to Final Proof
 For: DARYL A. FISHER


WATER RESOURCES DEPT.
 SALEM, OREGON

Location: The SE 1/4 of the NW 1/4
 of Section 26, T.5 S., R.4 W.,
 W.M., Yamhill County, Oregon.


Date: 05 November 1993

Application: R-69456


Permit: R-11265

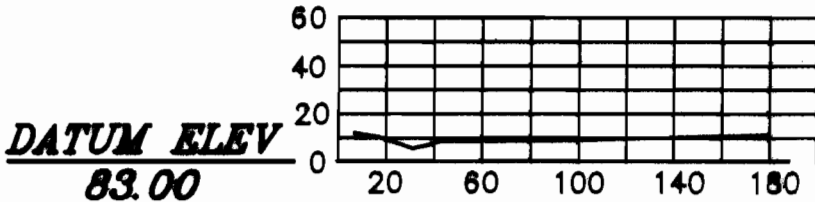

GROUP POND1
 SECTION A

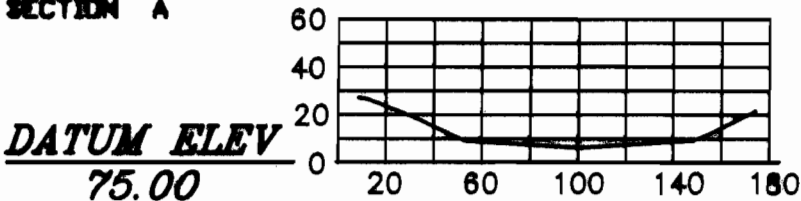


GROUP POND1
 SECTION B

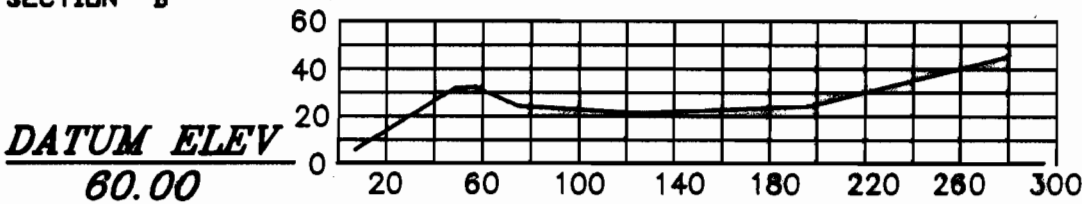

GROUP POND1
 SECTION C

RECEIVED
 NOV 19 1993

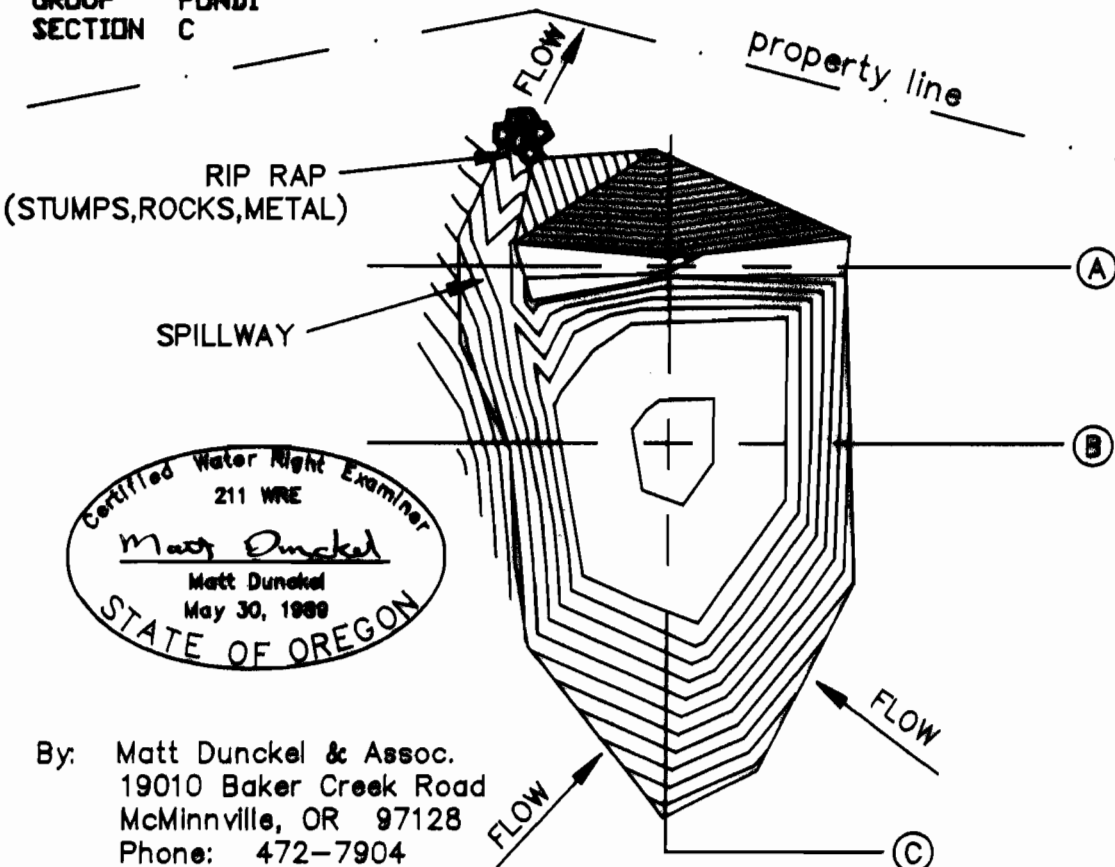

Certified Water Right Examiner
 211 WRE
Matt Dunckel
 Matt Dunckel
 STATE OF OREGON

By: Matt Dunckel & Assoc.
 19010 Baker Creek Road
 McMinnville, OR 97128
 Phone: 472-7904

T. 5 S., R. 4 W., W.M.

RECEIVED

Supplement to Final Proof
For: DARYL A. FISHER

MAY 16 1997
WATER RESOURCES DEPT.
SALEM, OREGON

Location: The SE 1/4 of the NW 1/4
of Section 26, T.5 S., R.4 W.,
W.M., Yamhill County, Oregon.

Date: 05 November 1993

Application: R-69456


Permit: R-11265

RECEIVED


NOV 19 1993

North


Scale: 1"=80'

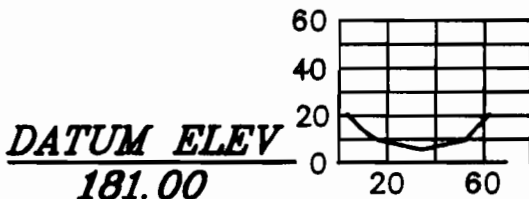


GROUP POND2
SECTION F

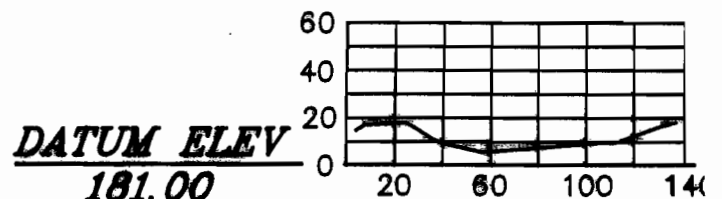

GROUP POND2
SECTION D


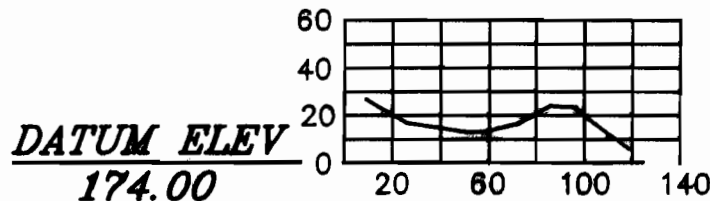


GROUP POND2
SECTION G

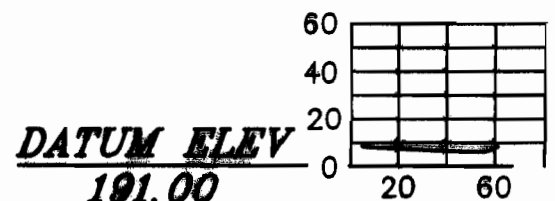

GROUP POND2
SECTION E

property line

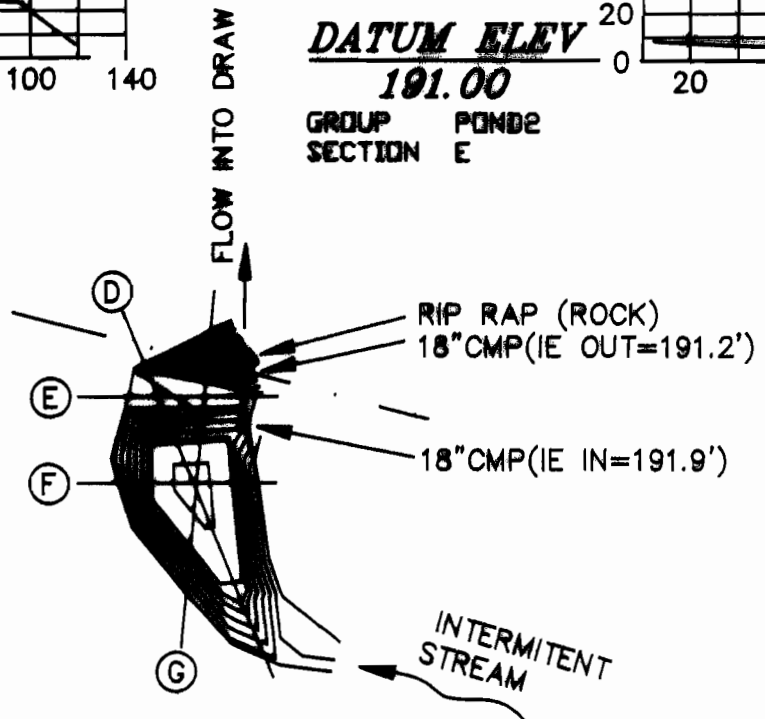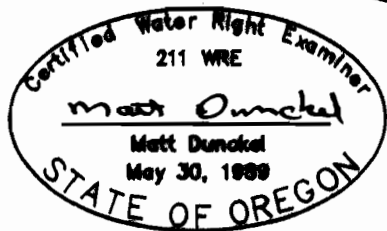

By: Matt Dunckel & Assoc.
19010 Baker Creek Road
McMinnville, OR 97128
Phone: 472-7904