


Section 1, T36S, R2W, Section 6, T36S, R1W, WM

ASSESSOR'S MAP No. 361W06 TL's 401, 600, 701

ASSESSOR'S MAP No. 362W01 TL's 601

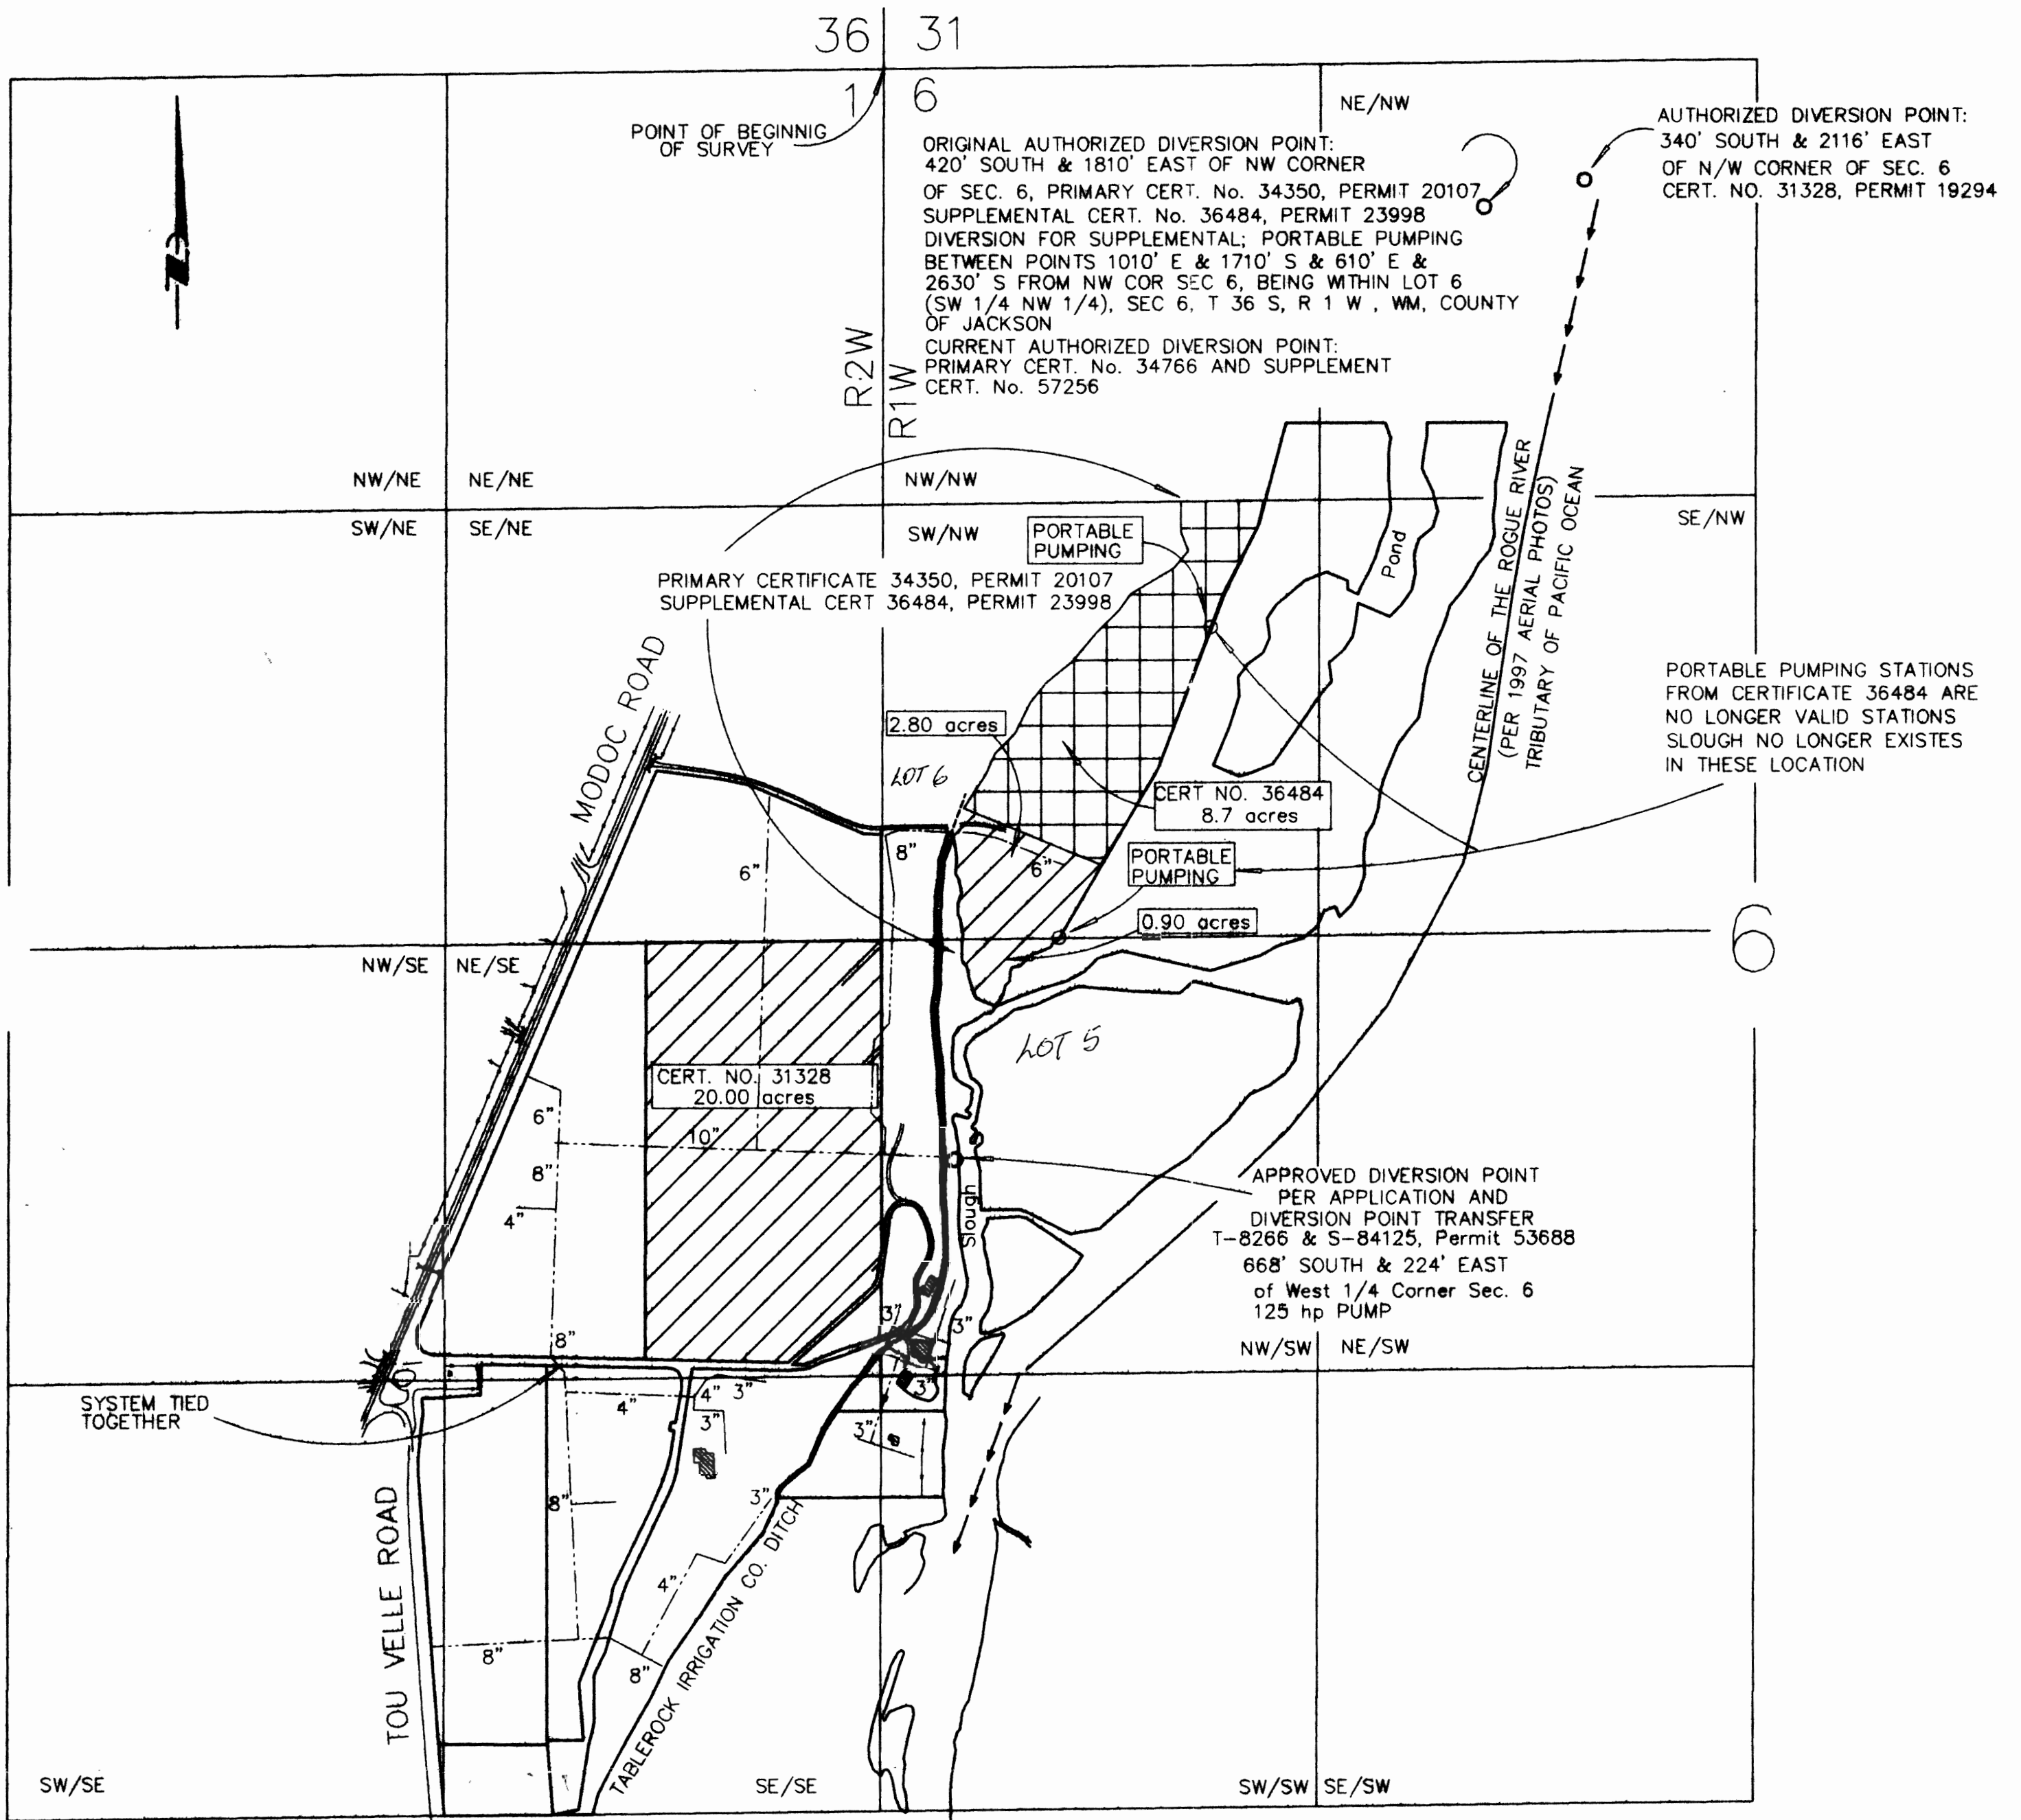


FINAL PROOF SURVEY  
UNDER

TRANSFER T-8266  
FOR IRRIGATION

----- BURIED MAIN LINE PIPES

 CURRENT CERTIFICATION, TRANSFER T-8266


TOWNSHIP	RANGE	SECTION	40-ACRE TRACT	ACRES
36S	1W	1	NE 1/4 OF SE 1/4	20.0
36S	1W	6	SW 1/4 OF NW 1/4	2.8
36S	1W	6	NW 1/4 OF SW 1/4	0.9

 REMAINDER OF 11.5 ACRES OF CERTIFICATE  
NO 34350P, 36484S NOT PART OF TRANSFER

SCALE 1" = 400'

DATED: JULY 16, 2002

PREPARED BY: FARBER & SONS, INC.  
FARBER SURVEYING  
120 MISTLETOE STREET  
MEDFORD, OREGON 97501  
541-776-0846  
hafarber@charter.net

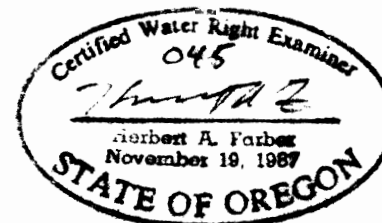

RENEWAL DATE 12-31-2003

PREPARATION OF THIS MAP IS FOR THE  
PURPOSE OF IDENTIFYING THE LOCATION  
OF THE WATER RIGHT ONLY. THIS MAP  
IS NOT TO BE USED TO LOCATE PROPERTY  
LINES OR DIMENSIONS