

RECEIVED

OCT - 2 1996

WATER RESOURCES DEPT.
SALEM, OREGON



N. E. RIVERSIDE AVE.

SW 1/4, SW 1/4

SE 1/4, SW 1/4

6
7

N. E. QUEENS

6 1/4
7

1
12

NW 1/4, NW 1/4

N. E. 42nd

N. E. 43rd

N. E. 44th

1912 WATER
RIGHT LIMIT

UMATILLA

NE 1/4, NW 1/4

POD, S 21° 00' 00" W
1429.35' FROM 1/4 6 & 7

KRUMBEIN ENGINEERING LTD.
ENGINEERS - SURVEYORS - PLANNERS
361 S.E. Second Pendleton, Oregon

Scale
1" = 400'
Date
9-22-96

Drawn By
HP
Ckd. By
DNK

Dwg. No.
9628A
Job No.
9319


Revision 1
Revision 2

FINAL PROOF MAP &
CLAIM OF BENEFICIAL USE

TELFORD'S

NE 1/4, NW 1/4, SECTION 7

T. 2 N., R. 33 E. W.M.

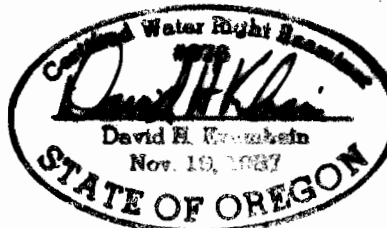

RENEWS 6/30/97

T-6967