


T17S.R.6W.W.M. SEC. 31
T18S.R.6W.W.M. SEC. 6
 LAKE COUNTY, OREGON

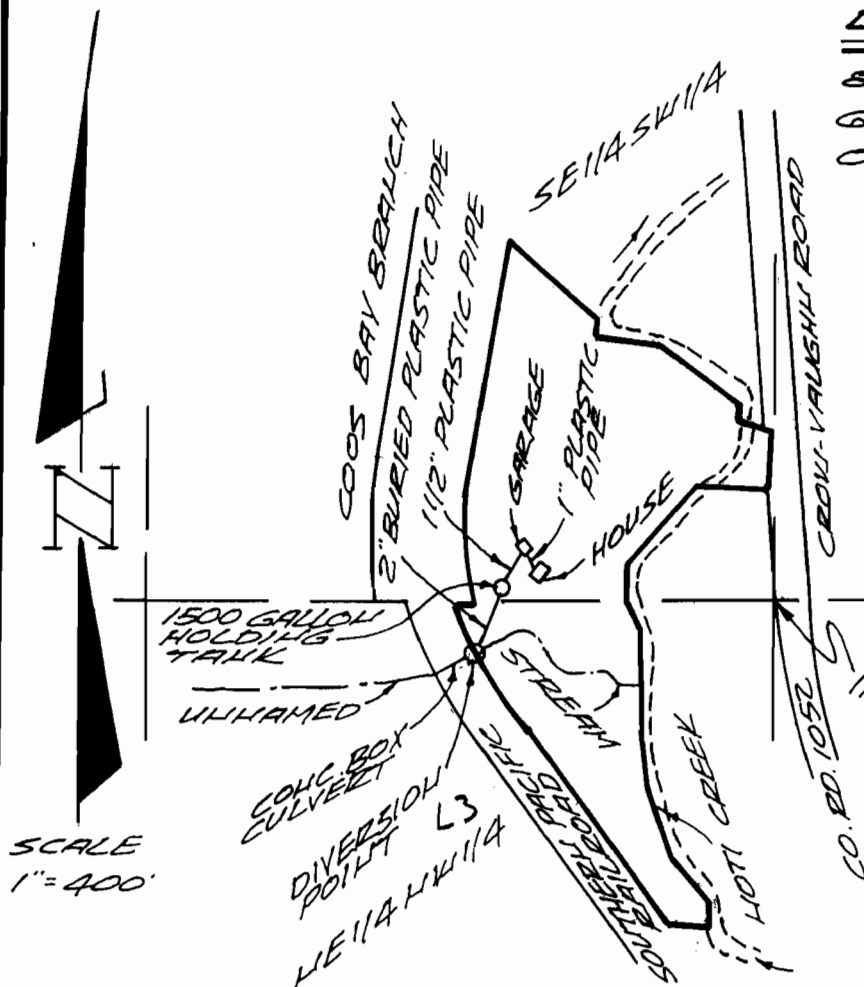

DIVERSION POINT

85.0 FEET SOUTH AND WEST
 644.0 FEET OF THE NORTH 1/4
 COR. SEC. 6, T18S.R.6W.W.M.

SW 1/4 SW 1/4

SEC. 31 T. 17 S. R. 6 W.

SEC. 6 T. 18 S. R. 6 W.

1/4 COR.

NW 1/4 NE 1/4

FINAL PROOF SURVEY
UNDER

APPLICATION NO. 71783 PERMIT NO. 51423
 BASIN 2 VOL. 4 HOTI CREEK & MISC. DISTRICT 2


IN NAME OF
THELMA D. BAKER-FISK

SURVEYED APRIL 18, 1995 BY:

Charles W. Guile
 CHARLES W. GUILLE

THIS MAP IS FOR WATER RIGHT
 PURPOSE ONLY AND IS NOT INTENDED
 TO PROVIDE DIMENSIONS FOR
 LOCATING PROPERTY BOUNDARIES

CHARLES W. GUILLE
& ASSOCIATES, CO.
 Land Surveying
 52 Centennial Loop
 Eugene, OR 97401

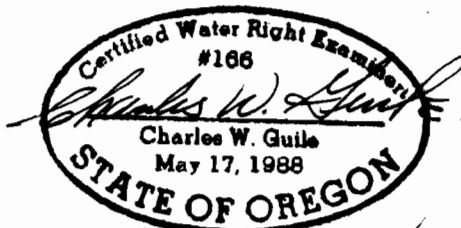

EXP. DATE 6/30/1995

Amended by WRD staff to include GLWT, 5-9-08 **89-28C**