G-8097
54427
T5803
55700
T5803

T. 25 S., R. 15 E., W.M.

WELL #2

WELL #1

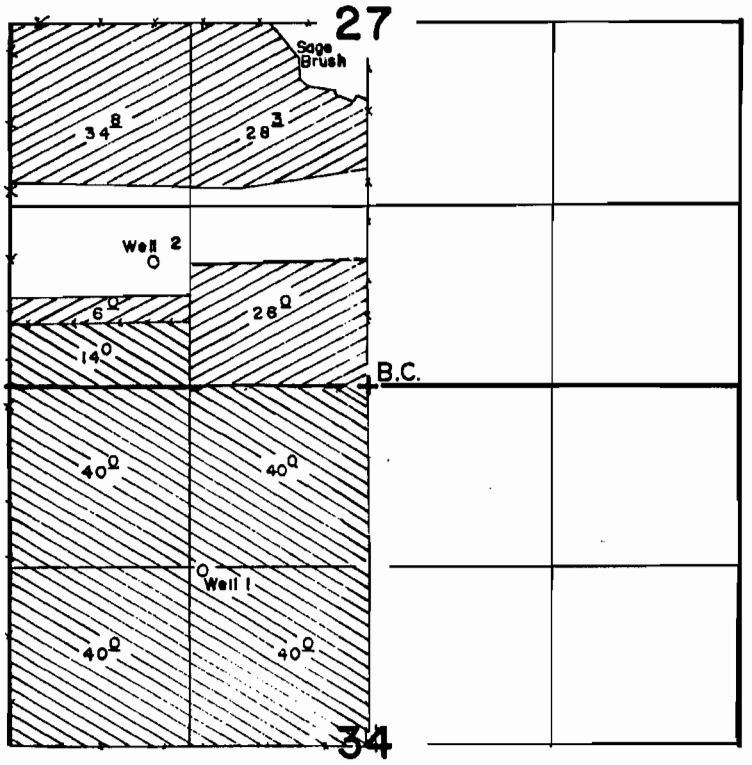

Well 1 Loc.: 1340' S. & 1200' W. from the N 1/4 Cor. Sec. 34

Well 2 Loc.: 900' N & 1580' W. from the N 1/4 Cor. Sec. 34

FINAL PROOF SURVEY

UNDER

Application No. G-8672 G-7254 Permit No. G-8097 G-6654

IN NAME OF

GEORGE H. WARMINGTON

Surveyed OCT. 20, 19 83, by L. TOLL

PTS 1983Y T.M.W.